11:30

IREDELL COUNTY HEALTH DEPARTMENT

STATESVILLE 704-878-5305 MOORESVILLE 704-664-5281

IMPROVEMENT PERMIT / AUTHORIZATION TO CONSTRUCT / OPERATION PERMIT / EXISTING SYSTEM INSPECTION

PERMIT# 78167 PIN# 4625 842807 PT 4625-99-4106 DATE 7/18/00

OWNER OR CONTRACTOR CRESCENT RESOURCES PHONE: Business 663-6405 J4COBS Home

ADDRESS 2214 BRAWLEY SCHOOL RD. MOORESVILLE

LOCATION BRAWLEY SCHOOL - TL BRAWLEY HARBOR - TR CLIFFLOOR - ON RT

SUBDIVISION POINT BLOCK / SECTION II LOT 243 LOT AREA 35937 ft² SITE CLASS. PS DESIGN FLOW 480GAD L.T.A.R. 25% 1/1 ✓

Septic Tank: 1000+ Gallons; STB 336 Date 7/17/00

Pump Tank: 1000+ Gallons; PT 27 Date 7/14/00

Pump Make: MEYERS Model ME3F-21 Serial No. 3-14-00

Nitrification Field: No Fields 1 Square Feet 1440 Linear Feet 480

No Lines 8@60' Trench Width 36" Max Trench Bottom Depth 36-48" Gravel Depth N/A

☑ New System ☐ Repair System Type: I, II, (III), IV, V, VI

System Description: PUMP INNOVATIVE

Repair System Description: PUMP PANEL

Maintenance Agreement Required: ☐ Yes ☑ No

☑ House/Mod. Home No. Bedrooms 4

☐ Mobile Home No. Bathrooms 4

☐ Business No. Employees

☐ Other

☐ Slab ☑ Crawl Space ☐ Basement w/plumbing ☐ Basement wo/plumbing


Water Supply: ☐ Individual ☐ Public ☐ ~~Community~~

Comments:/Conditions:

Comments:/Conditions:

1"=50'

INITIAL SITE SKETCH

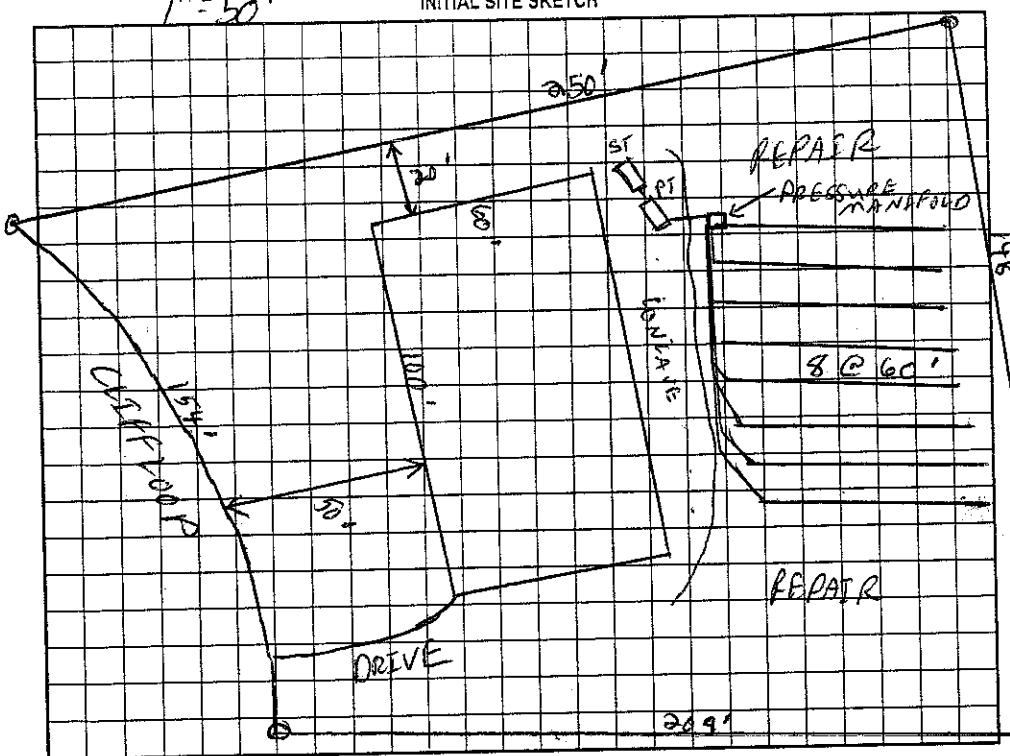

AS BUILT SKETCH

Permit can be suspended or revoked if any false information is supplied toward securing the permit/any unauthorized changes are made to the site/any unauthorized changes are made in the installation of the system. Improvement Permit with plat valid without expiration; Improvement Permit with site plan valid for sixty months. Authorization to Construct is valid for a period equal to that of Improvement Permit – not to exceed sixty months.

Signed: 8/10/00 date

Improvement Permit by: RS date 7/18/00

Authorization to Construct by: RS date 7/18/00

Installed by: Mayhew

Operation Permit by: RS date 10/24/00

Existing System Inspection by: date

HEALTH DEPT. COPY: WHITE OWNER COPY (FINAL): YELLOW OWNER COPY (INITIAL): PINK