IREDELL COUNTY HEALTH DEPARTMENT

STATESVILLE 704-878-5305 50.00 Paid MOORESVILLE 704-664-5281

2:00

IMPROVEMENT PERMIT / AUTHORIZATION TO CONSTRUCT / OPERATION PERMIT / EXISTING SYSTEM INSPECTION

PERMIT# 078209 PIN# 4625842807 (pt.) 4625-99-5524 DATE Feb 15, 01

OWNER OR CONTRACTOR Crescent Resources-Inc // Diesel Custom Homes PHONE: Business Home

ADDRESS 2214 Brawley Sch Rd Mrsv.

LOCATION Brawley Sch Rd TL Brawley Harbor Place on left

SUBDIVISION The Point BLOCK / SECTION II LOT 264 LOT AREA 38,444 sf+ 264A SITE CLASS. RS DESIGN FLOW 480 gpd L.T.A.R. .25

Septic Tank: ~~1000~~ 500 Gallons; STB 338 Date 7-15-01

Pump Tank: 1000 Gallons; PT 27 Date 6-22-01

Pump Make: Model Serial No.

Nitrification Field: No Fields 1 Square Feet 640/960 Linear Feet 320

No Lines 4 Trench Width 24"* Max Trench Bottom Depth ~30" Gravel Depth N/A

☑ New System ☐ Repair System Type: I, II, III, IV, V, VI

System Description: LPP PBPS

Repair System Description: LPP PBPS on 264A

Maintenance Agreement Required: ☑ Yes ☐ No

☑ House/Mod. Home No. Bedrooms 4

☐ Mobile Home No. Bathrooms 4

☐ Business No. Employees

☐ Other

☐ Slab ☐ Crawl Space ☑ Basement w/plumbing ☐ Basement wo/plumbing

Water Supply: ☐ Individual ☑ Public ☐ Community


Comments/Conditions: *36" trenches, 9' on center may be used.

Reviewed house and site plans; appears in compliance w/ I.P.

Comments/Conditions: Panel lines installed 3' wide.

1"=50'

INITIAL SITE SKETCH

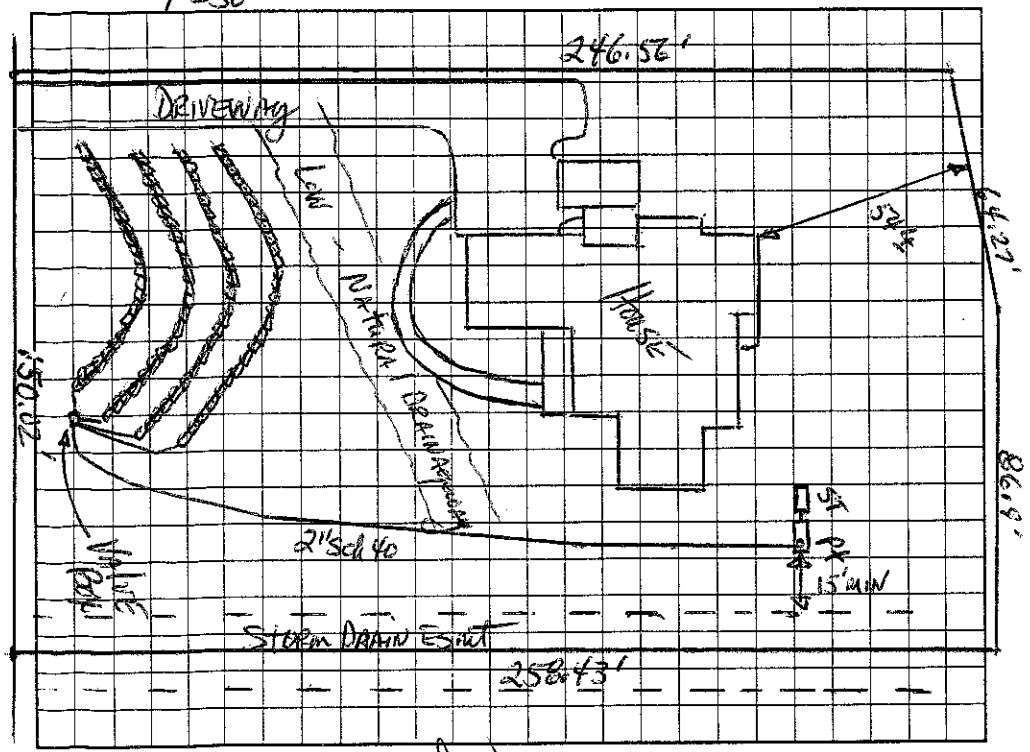

AS BUILT SKETCH

Installed as Drawn.

Permit can be suspended or revoked if any false information is supplied toward securing the permit/any unauthorized changes are made to the site/any unauthorized changes are made in the installation of the system. Improvement Permit with plat valid without expiration. Improvement Permit with site plan valid for sixty months. Authorization to Construct is valid for a period equal to that of Improvement Permit – not to exceed sixty months.

Signed: date 2-15-01

Improvement Permit by: J Hartman, RS date 2-15-01

Authorization to Construct by: J Hartman, RS date 2-15-01

Installed by: R&H Trenching RS

Operation Permit by: Marion Hall Dotson date 11/24/01

Existing System Inspection by: date

HEALTH DEPT. COPY: WHITE OWNER COPY (FINAL): YELLOW OWNER COPY (INITIAL): PINK