IREDELL COUNTY HEALTH DEPARTMENT

4625-99-8224

STATESVILLE 704-878-5305 — MOORESVILLE 704-664-5281

IMPROVEMENT PERMIT / AUTHORIZATION TO CONSTRUCT / OPERATION PERMIT / EXISTING SYSTEM INSPECTION

PERMIT# 078172 PIN# 4625842807 (pt.) Hughes, Hamelink & Zande DATE March 22, '99

OWNER OR CONTRACTOR Crescent Resources, The Point on Belmont PHONE: Business _____ Home _____

ADDRESS 2214 Brawley Sch Rd, Mooresville

LOCATION Brawley Sch Rd. N. Brawley Harbor Place TR Cliff Loop #120

SUBDIVISION The Point BLOCK / SECTION II LOT 248 LOT AREA 39,524 sf SITE CLASS RS DESIGN FLOW 480 gpd L.T.A.R. .3

Septic Tank: ~~1000~~ 1500 Gallons; STB 338 Date 8-30-02

Pump Tank: 1000 Gallons; PT 283 Date 7-29-02

Pump Make: Myers Model ME-3E-21 Serial No 2622900 01

Nitrification Field: No. Fields 1 Square Feet 840 Linear Feet 280

No Lines 4@70' Trench Width 36" Max Trench Bottom Depth 36"

☑ New System ☐ Repair System Type: I, II, III, (IV) V, VI

System Description: LP Panel Block

Repair System Description: SAME

Maintenance Agreement Required: ☑ Yes ☐ No

Gravel Depth N/A

☑ House/Mod. Home No. Bedrooms 4/4

☐ Mobile Home No. Bathrooms 4/4

☐ Business No. Employees ____

☐ Other ____


☐ Slab ☑ Crawl Space ☐ Basement w/plumbing ☐ Basement wo/plumbing

Water Supply: ☐ Individual ☑ ~~Public~~ ☑ Community


Comments:/Conditions:

Comments:/Conditions: Reviewed Building plans 5/20/02; in compliance with Septic permit 5/16" hole drilled; 16 panels per ditch Checked tanks & lines 10/3/2002 mo Press. tested & alarm 10/23/02

INITIAL SITE SKETCH

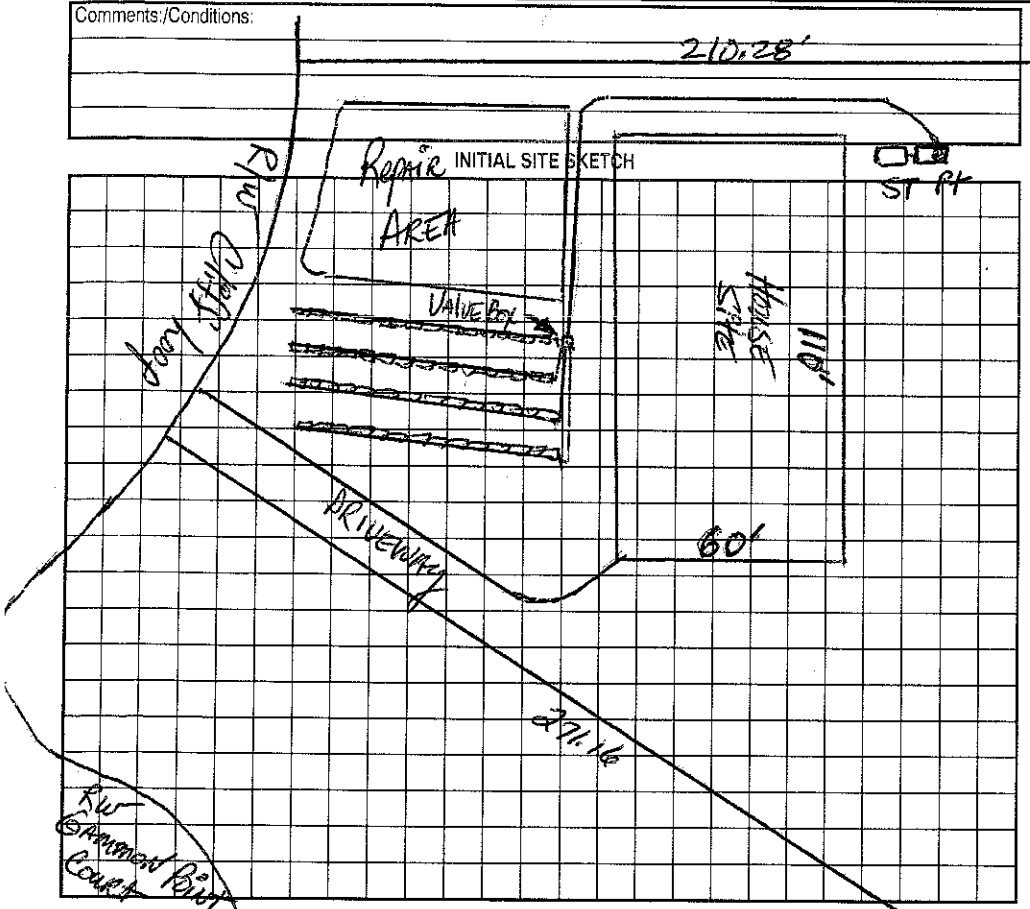

AS BUILT SKETCH 1"=50'

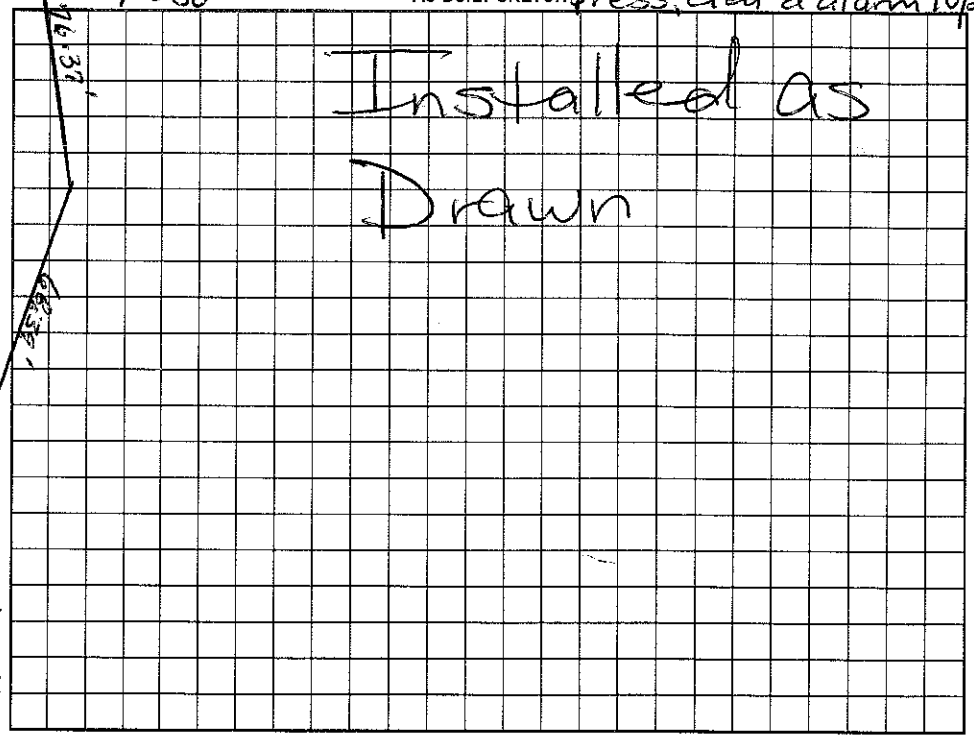

Permit can be suspended or revoked if any false information is supplied toward securing the permit/any unauthorized changes are made to the site/any unauthorized changes are made in the installation of the system. Improvement Permit with plat valid without expiration. Improvement Permit with site plan valid for sixty months. Authorization to Construct is valid for a period equal to that of Improvement Permit – not to exceed sixty months.

Signed: _____ date 3/24/99

Improvement Permit by: _____ date 3-22-99

Authorization to Construct by: _____ RS date 5/20/02

Installed by: Mayhew, Septic RS

Operation Permit by: _____ RS date 10/23/02

Existing System Inspection by: _____ date _____

HEALTH DEPT. COPY: WHITE OWNER COPY (FINAL): YELLOW OWNER COPY (INITIAL): PINK