IREDELL COUNTY HEALTH DEPARTMENT

Statesville Office (704) 878-5305 Mooresville Office (704) 660-3625

PERMIT # 205122

IMPROVEMENT PERMIT / AUTHORIZATION TO CONSTRUCT / OPERATION PERMIT / EXISTING SYSTEM

PIN # 4625998623

APPLICANT: WILLIAM GOODWIN APPLICANT ADDRESS: 18633 PENINSULA CLUB DR CORNELIUS NC

SITE ADDRESS: 155 BRAWLEY HARBOR PLACE - Mooresville PHONE: 704-661-9801 ALT. PHONE:


SITE DIRECTIONS: BRAWLEY SCH RD (2) BRAWLEY HARBOR LOT ON (1)

SUBDIVISION: POINT on Norman SECTION: 2 LOT # 262 LOT AREA: 39,841 DESIGN FLOW: 480 L.T.A.R.: .3


Septic Tank	1500 (gal)	STB 444	Date 12-10-15	[X] New System [ ] Repair [ ] Expansion	System Type: I II III IV V VI	[X] Residence	No. Bedrooms	4	Water Supply
Pump Tank	— (gal)	PT —	Date —	System Description: 25% REDUCTION		[ ] Business	No. Persons	8	[ ] Private
Pump Make	—	Model —	Serial # —	Repair System Description: PPBPS - LPP		[ ] Other	No. Employees	—	[ ] Public
# Nitrification Fields	1	# Lines 5	Linear Ft: 400	Maintenance Agreement Required: [X] YES REPAIR [ ] NO		[ ] Slab	[X] Crawl Space		[X] Community
Trench Width	3'	Max. Trench Bottom Depth 30"	Gravel Depth NA	[ ] GRAVITY [ ] PRESSURE		[ ] Basement w/plumbing			[ ] Basement w/o plumbing

Comments / Conditions: KEEP LINES ON CONTOUR AS PER SITE PLAN

INITIAL SITE SKETCH

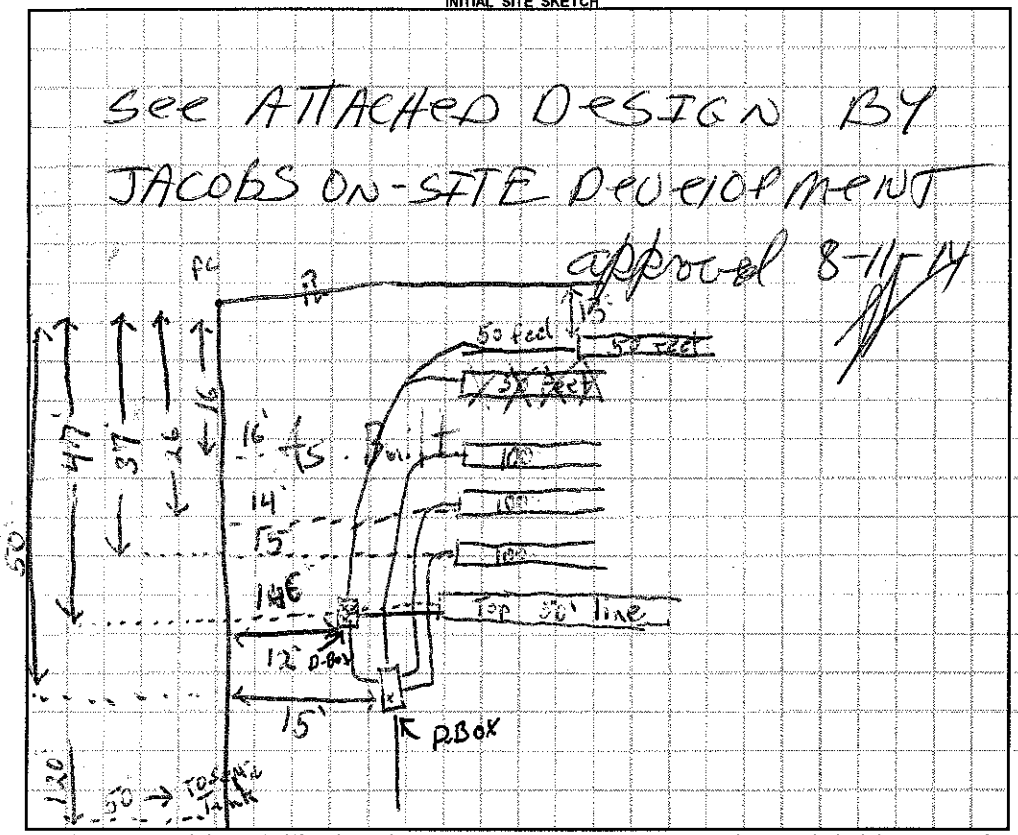

AS BUILT SKETCH

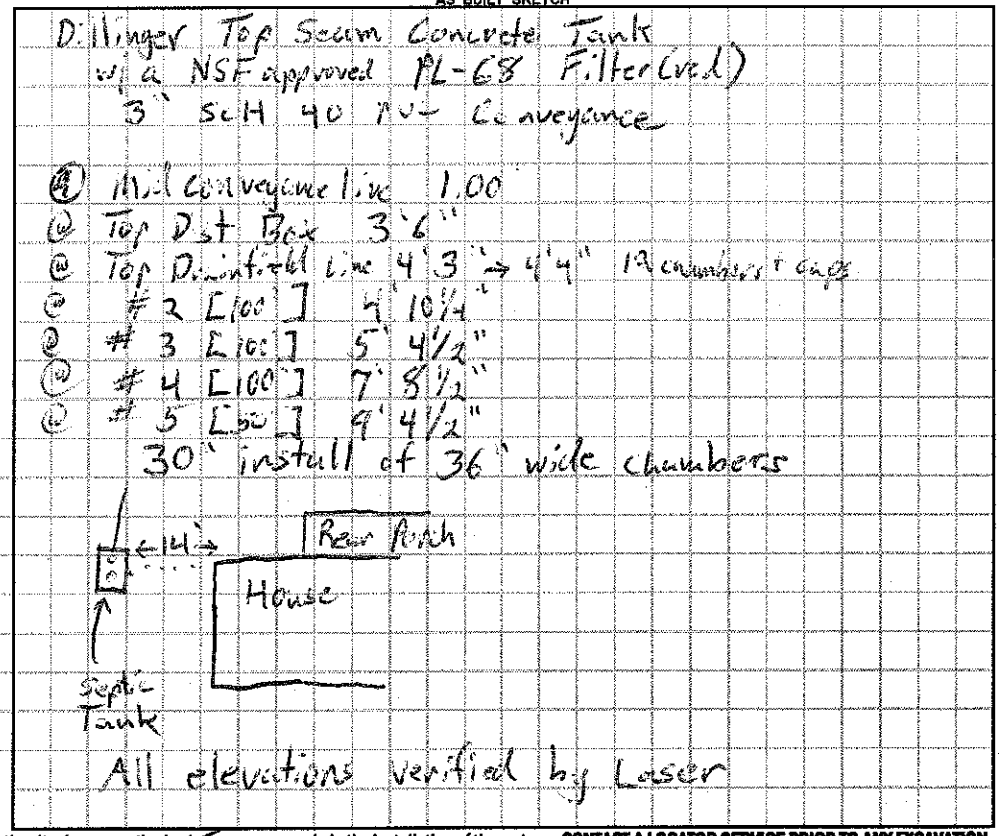

Permit can be suspended or revoked if any false information is supplied toward securing the permit / any unauthorized changes are made to the site / any unauthorized changes are made in the installation of the system. **CONTACT A LOCATOR SERVICE PRIOR TO ANY EXCAVATION**

[ ] **IMPROVEMENT PERMIT** *with plat valid without expiration.* [X] **IMPROVEMENT PERMIT** *with site plan valid for 60 mos.* [X] **AUTHORIZATION TO CONSTRUCT** *valid for period equal to IMPROVEMENT PERMIT--not to exceed 60 mo.*


Owner / Applicant Signature: [signature] Date: 8/13/14 Installed by: Richard Abernathy

IMPROVEMENT PERMIT by: [signature] REHS-LSS Date: 8-11-14 OPERATION PERMIT by: Tom Church Date: 1-20-16

AUTHORIZATION TO CONSTRUCT by: [signature] REHS-LSS Date: 8-11-14 Existing System Inspected by: Date:

Health Dept. Copy - WHITE Applicant (Final Approval) - YELLOW Applicant (Conditional Approval) - PINK

Arthur Rutenberg Homes

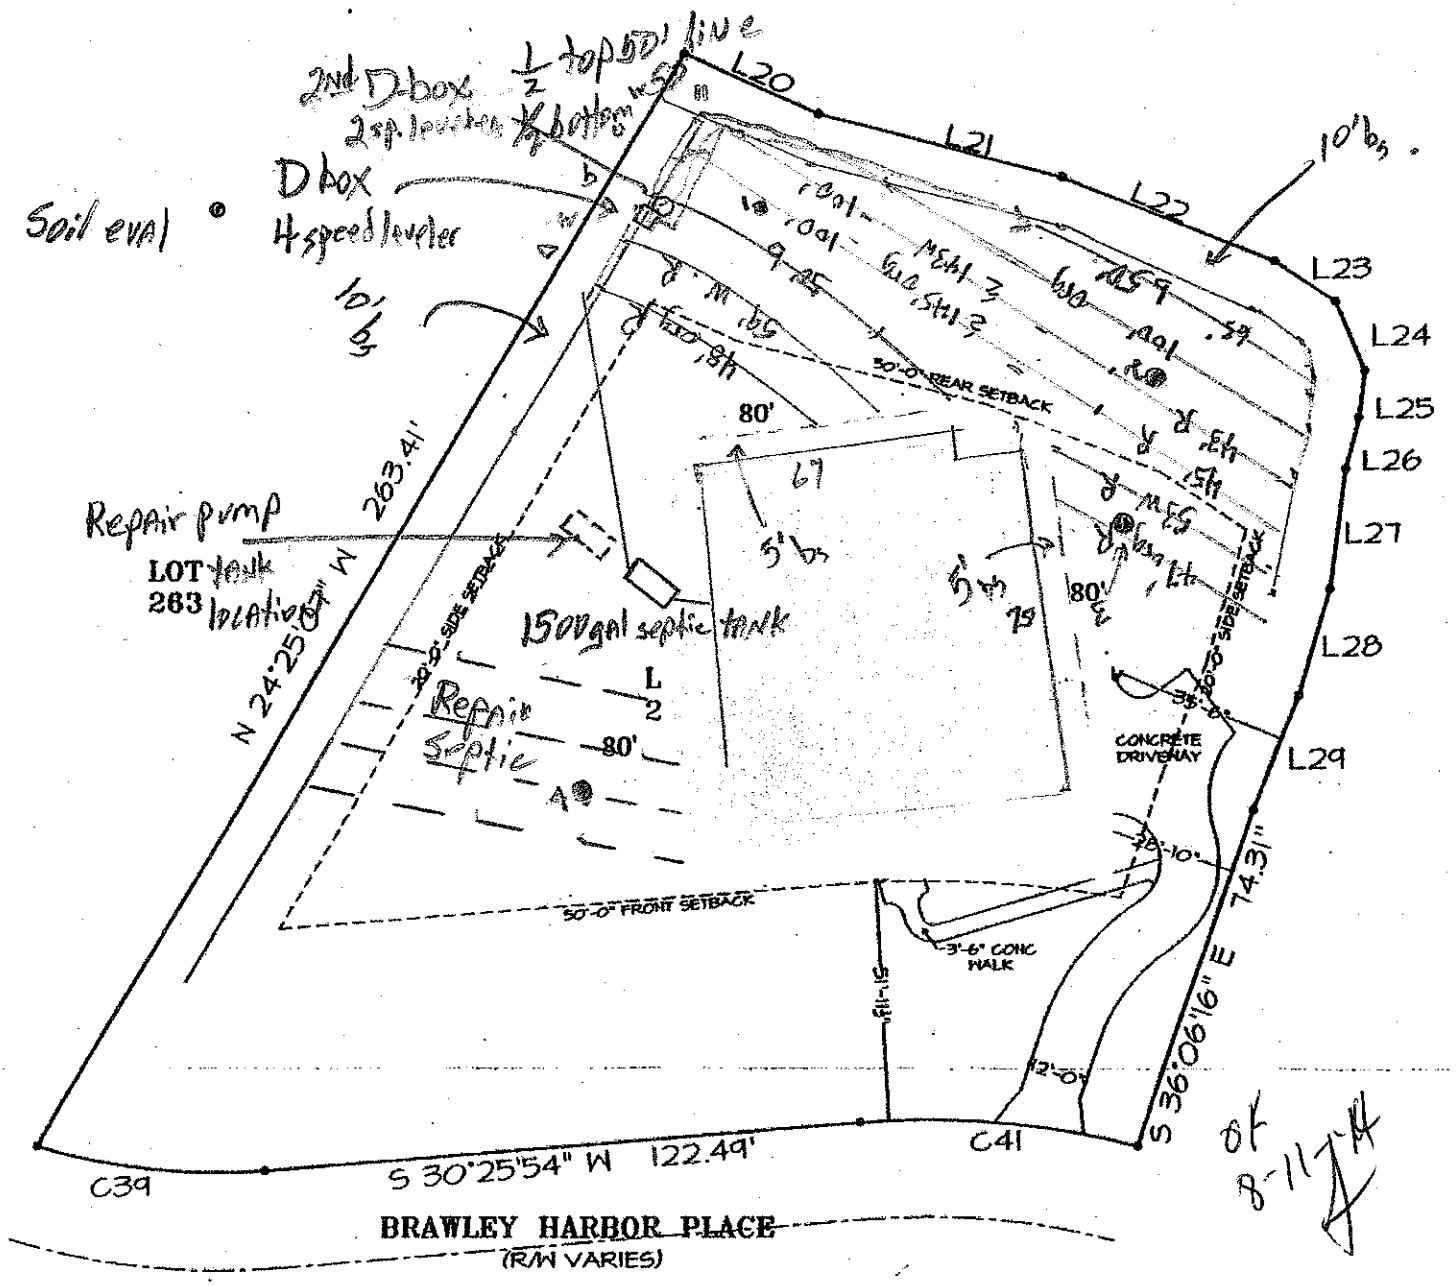

LINE DATA:		
LINE	LENGTH	CHORD BRNG
L20	30.16'	N 59°45'56" E
L21	51.46'	N 44°56'14" E
L22	46.79'	N 36°54'08" E
L23	14.98'	N 64°07'05" E
L24	15.82'	S 16°58'11" E
L25	10.07'	S 46°15'01" E
L26	11.06'	S 59°30'58" E
L27	24.48'	S 41°33'55" E
L28	22.91'	S 36°29'10" E
L29	25.19'	S 52°42'34" E

CURVE DATA:					
CURVE	RADIUS	LENGTH	CHORD	DELTA	CHORD BRNG
C39	121.22'	47.16'	46.84'	21°14'11"	S 41°33'16" W
C41	110.00'	51.15'	50.68'	19°15'36"	S 40°03'42" W

LOT AREAS:		
HOUSE	4,952	SQ. FT.
DRIVEWAY (TO PROPERTY LINE)	1,886	SQ. FT.
WALKWAY	256	SQ. FT.
CONCRETE PAD, PLANTERS, WALLS	N/A	SQ. FT.
PERVIOUS	87,953	SQ. FT.
TOTAL	94,841	SQ. FT.

SCALE: 1" = 40'

Note: Plan information is conceptual only. Certain items may be changed at production stage. Clouded areas modified to accommodate change requests.

Franchise:	#98 Bluefield Builders, LLC	
File # :	Goodwin-LF-A	1221F-R-01-2S/1F- "B"
Drawn By:	MDF	
Date:	July 30, 2014	

A Custom Residence for:

Mr. and Mrs. Goodwin

The Point, Phase 2, Lot 262