IREDELL COUNTY HEALTH DEPARTMENT

Statesville Office (704) 878-5305 | Mooresville Office (704) 660-3625 | PERMIT # 209541

IMPROVEMENT PERMIT / AUTHORIZATION TO CONSTRUCT / OPERATION PERMIT / EXISTING SYSTEM

PIN # 4625-99-9400

APPLICANT: RANDALL STUTTS | APPLICANT ADDRESS: 4300 SHARON RD. APT. 343 CHARLOTTE NC

SITE ADDRESS: 150 BRAWLEY HARBOR PLace - Mroad | PHONE: | ALT. PHONE:

SITE DIRECTIONS: BSR, TL BRAWLEY HARBOR

SUBDIVISION: THE POINT ON NORMAN | SECTION: 2 | LOT # 249 | LOT AREA: | DESIGN FLOW: 480 | L.T.A.R.: .25

Septic Tank 1500 (gal) | STB 338 | Date 3-14-16

Pump Tank (gal) | PT | Date

Pump Make | Model | Serial #

Nitrification Fields 1 | # Lines 6 | Linear Ft: 480'

Trench Width 36" | Max. Trench Bottom Depth *24-30"* | Gravel Depth

☒ New System ☐ Repair ☐ Expansion | System Type: I II (III) IV V VI

System Description: 25% REDUCTION PANEL

Repair System Description:

Maintenance Agreement Required: ☐ YES ☒ NO

☒ GRAVITY ☐ PRESSURE

☒ Residence ☐ Business ☐ Other ☐ Slab ☐ Basement w/plumbing

No. Bedrooms 4 | No. Persons | No. Employees | ☒ Crawl Space

Water Supply: ☐ Private ☐ Public ☒ Community

☐ Basement w/o plumbing

Comments / Conditions:

4/19/16 Checked ST & drainlines.

INITIAL SITE SKETCH

SEE PLAN FROM MICHAEL ATHANAS & ASSOCIATES

AS BUILT SKETCH

Installed Quick 4

Permit can be suspended or revoked if any false information is supplied toward securing the permit / any unauthorized changes are made to the site / any unauthorized changes are made in the installation of the system. **CONTACT A LOCATOR SERVICE PRIOR TO ANY EXCAVATION**

☐ **IMPROVEMENT PERMIT** *with plat valid without expiration.* ☒ **IMPROVEMENT PERMIT** *with site plan valid for 60 mos.* ☐ **AUTHORIZATION TO CONSTRUCT** *valid for period equal to IMPROVEMENT PERMIT--not to exceed 60 mo.*

Owner / Applicant Signature: | Date: 5/12/15

IMPROVEMENT PERMIT by: | Date: APPROVED APR 14 2015

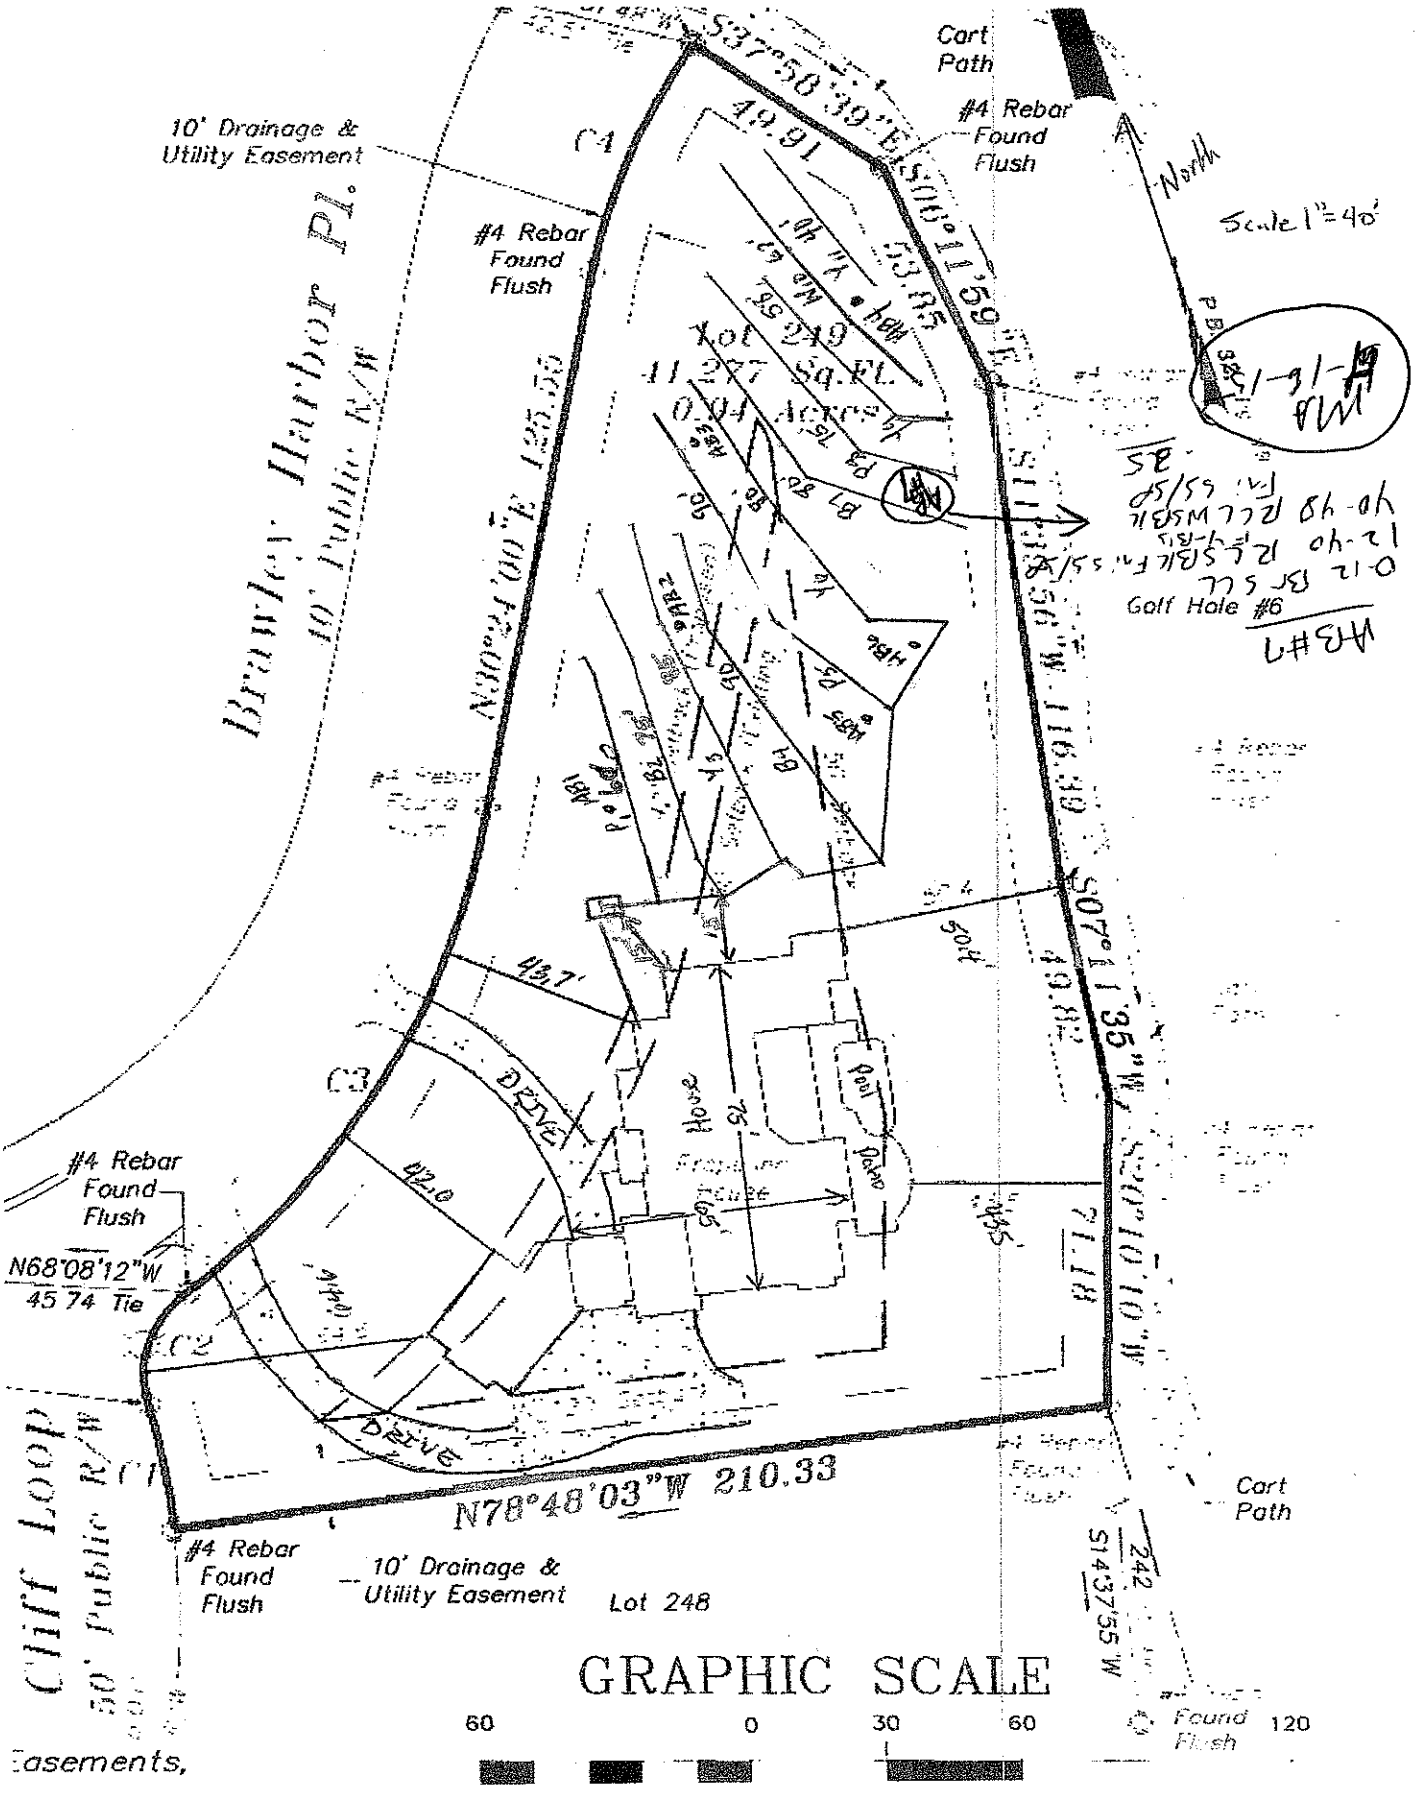
AUTHORIZATION TO CONSTRUCT by: | Date: APPROVED MAY 15 2015

Installed by: Richard Abernathy Master Tech RS | Date: 4/19/16

OPERATION PERMIT by: | Date:

Existing System Inspected by: | Date:

Health Dept. Copy - WHITE | Applicant (Final Approval) - YELLOW | Applicant (Conditional Approval) - PINK


50' Public R/W
Cliff Loop
50' Public R/W
10' Drainage & Utility Easement
#4 Rebar Found Flush
Cart Path
North
Scale 1"=40'
S37°50'39"E 49.91
S10°11'59"E 53.85
N30°24'00"E 135.56
S07°11'35"W 116.98
S07°11'10"W 49.82
N78°48'03"W 210.33
S14°37'55"W 242
Golf Hole #6
Lot 248
GRAPHIC SCALE
60 0 30 60 120

Easements,