IREDELL COUNTY HEALTH DEPARTMENT

Statesville Office (704) 878-5305 Mooresville Office (704) 660-3625 PERMIT # 205844 ALP

IMPROVEMENT PERMIT / AUTHORIZATION TO CONSTRUCT / OPERATION PERMIT / EXISTING SYSTEM

PIN # 4626-00-1137 ✓

APPLICANT: Ray Short APPLICANT ADDRESS: —

SITE ADDRESS: 320 Barker Loop Mooresville NC PHONE: — ALT. PHONE: —

SITE DIRECTIONS: BSR, R Chucknood, L Barker Loop, Site on R

SUBDIVISION: Watertree Landing SECTION: 4 LOT # 81 LOT AREA: .71 Acre DESIGN FLOW: 480 GPD L.T.A.R.: .3

Septic Tank 1000 (gal) STB 825 Date 1/7/15
Pump Tank 1000 (gal) PT 302 Date 1/12/15
Pump Make Zoeller Model N 152 Serial #
Nitrification Fields 1 # Lines 4 @ 100' Linear Ft: 400'
Trench Width 36" Max. Trench Bottom Depth 36" Gravel Depth N/A

☑ New System ☐ Repair ☐ Expansion System Type: I II III IV V VI
System Description: 25% Reduction - Pump
Repair System Description: LP PPBPS
Maintenance Agreement Required: ☐ YES ☒ NO ☐ GRAVITY ☒ PRESSURE

☑ Residence ☐ Business ☐ Other ☐ Slab ☐ Basement w/plumbing
No. Bedrooms 4 No. Persons 8 No. Employees
☒ Crawl Space ☐ Basement w/o plumbing

Water Supply: ☑ Private ☐ Public ☐ Community

Comments / Conditions: Initial System Modified Due To Change In Plumbing And Drainfield For Initial Was Moved Uphill. Plat Was Also Altered. Initial Install For Drainfield And Tanks Were

Checked By [illegible]. OLD Permit Is Revoked From Plat Change. This Permit Is A Drawn By The Oaks Group With A Pool Addition.

INITIAL SITE SKETCH

See Approved / Attached Design By The Oaks Group.

Dated APPROVED MAR 30 2015

Control Box Checked And Risers 3/27/15 SL

AS BUILT

Permit can be suspended or revoked if any false information is supplied toward securing the permit / any unauthorized changes are made to the site / any unauthorized changes are made in the installation of the system. **CONTACT A LOCATOR SERVICE PRIOR TO ANY EXCAVATION**

☐ **IMPROVEMENT PERMIT** *with plat valid without expiration.* ☑ **IMPROVEMENT PERMIT** *with site plan valid for 60 mos.* ☑ **AUTHORIZATION TO CONSTRUCT** *valid for period equal to IMPROVEMENT PERMIT--not to exceed 60 mo.*

Owner / Applicant Signature: Date: 4/8/15 Installed by: Broward Septic

IMPROVEMENT PERMIT by: APPROVED Date: MAR 30 2015 OPERATION PERMIT by: Date: 4-8-15

AUTHORIZATION TO CONSTRUCT by: APPROVED Date: MAR 30 2015 Existing System Inspected by: Date:


Health Dept. Copy - WHITE Applicant (Final Approval) - YELLOW Applicant (Conditional Approval) - PINK

OK 3/23/17

AS BUILT

4 SCH 80 TAPS

w/ N 152 ZOELLER PUMP.

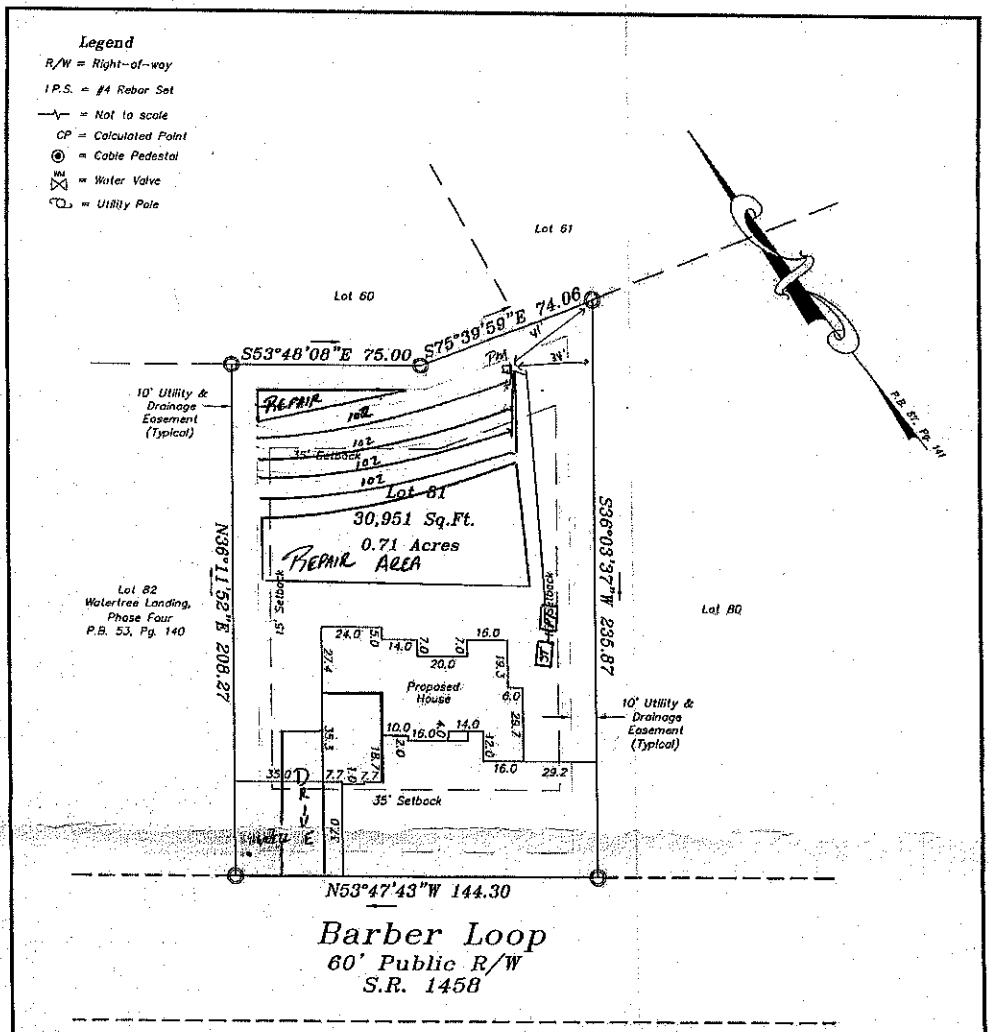

Notes:


1) This property may be subject to any Easements, Rights-of-way, and/or Restrictive Covenants.
2) Boundary information based on Plat Book: 57 at Page: 141 as recorded in the Iredell County Register of Deeds.
3) This survey is of an existing parcel or parcels of land.
4) No N.C.G.S. or U.S.G.S. Monuments could be located within 2000'.
5) Area by coordinate method.

GRAPHIC SCALE

50 0 25 50 100

(IN FEET)
1 inch = 50 ft.

Vicinity Map

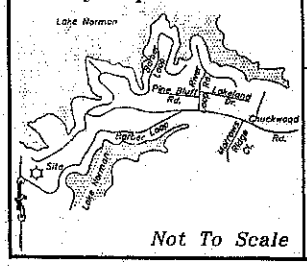


Not To Scale

Plot Plan
FOR
Lake Luxury Homes, Inc.

PROPERTY DESCRIPTION
Lot 81
Watertree Landing, Phase 4
P.B. 57, Pg. 141
Davidson Township
Iredell County, NC

SCALE: 1" = 50'
FIELD BOOK:
FILE: 2014-153
TAX MAP NO: 4626001137

Schamback Surveying, P.A.
Post Office Box 4143
Mooresville, NC 28117
(704) 622-9915
C-3218

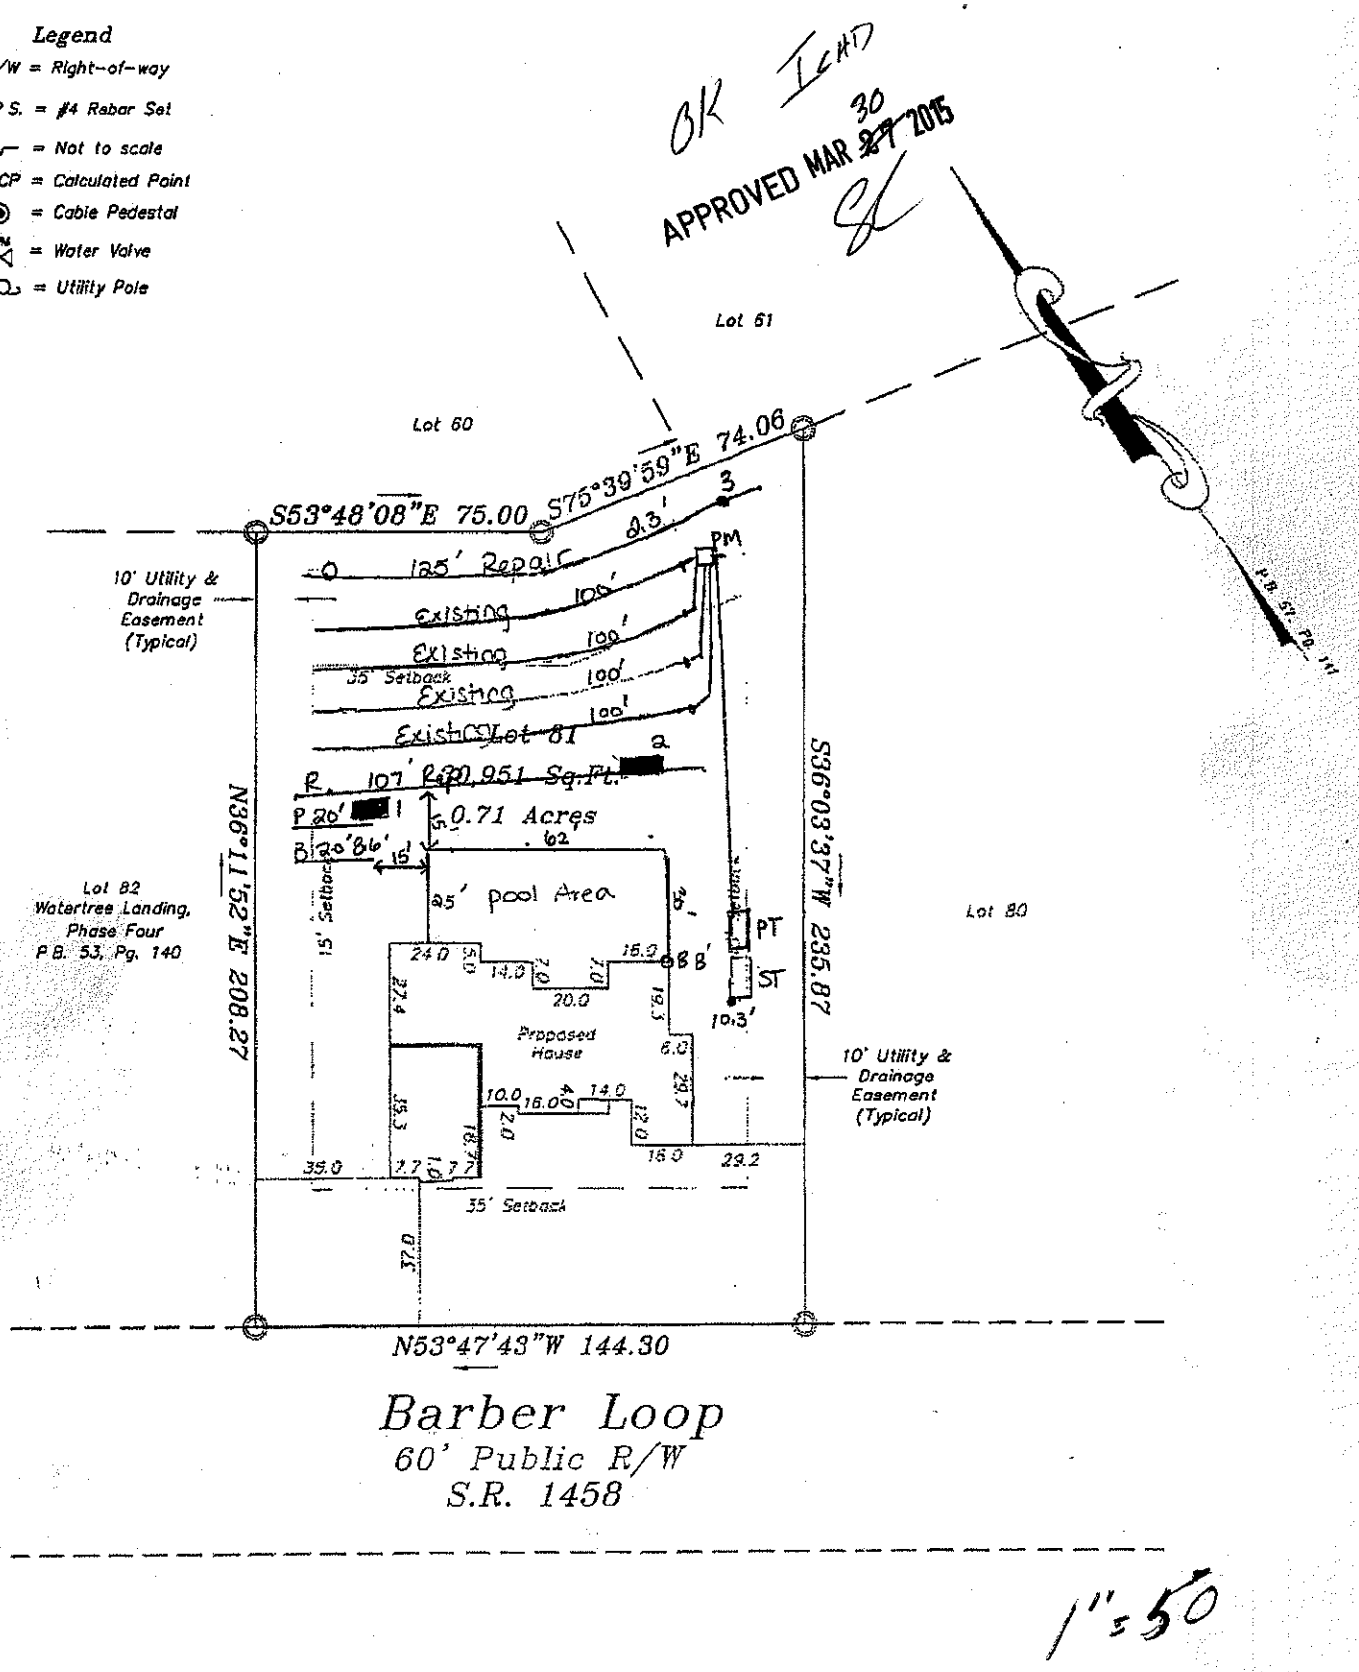

Notes:

1) This property may be subject to any Easements, Rights-of-way, and/or Restrictive Covenants.
2) Boundary information based on Plat Book: 57 at