IREDELL COUNTY HEALTH DEPARTMENT

Statesville Office (704) 878-5305 Mooresville Office (704) 660-3625 PERMIT # 148862

IMPROVEMENT PERMIT / AUTHORIZATION TO CONSTRUCT / OPERATION PERMIT / EXISTING SYSTEM

PIN # 4626-00-1399

APPLICANT: LAKE LUXURY HOMES APPLICANT ADDRESS: PO BOX 3792 MOORESVILLE 28117

SITE ADDRESS: 548 BARBER LOOP PHONE: 704-516-2344 ALT. PHONE:

SITE DIRECTIONS: BSR, CHUCKWOOD, TL 2ND BARBER LOOP, ON L

SUBDIVISION: WATERTREE LANDING SECTION: LOT # 60 LOT AREA: .7AC DESIGN FLOW: 480 L.T.A.R.: .3

Septic Tank 1000 (gal) STB 825 Date 7-22-13
Pump Tank (gal) PT Date
Pump Make Model Serial #
Nitrification Fields 1 # Lines 4@100' Linear Ft: 400'
Trench Width 36" Max. Trench Bottom Depth 36" Gravel Depth —


☒ New System ☐ Repair ☐ Expansion System Type: I II (III) IV V VI
System Description: 25% REDUCTION
Repair System Description: PANEL
Maintenance Agreement Required: ☐ YES ☒ NO
☒ GRAVITY ☐ PRESSURE

☒ Residence ☐ Business ☐ Other ☐ Slab ☐ Basement w/plumbing
No. Bedrooms 4 No. Persons No. Employees
☒ Crawl Space ☐ Basement w/o plumbing

Water Supply: ☒ Private ☐ Public ☐ Community

Comments / Conditions:

INITIAL SITE SKETCH

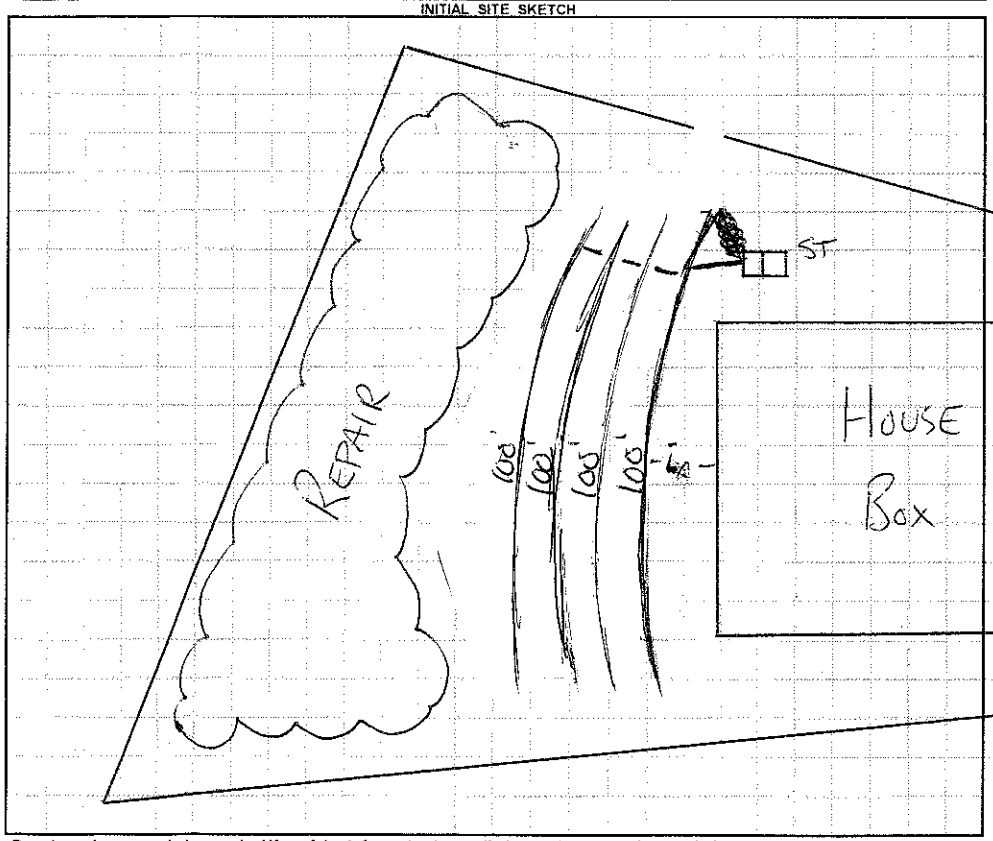

AS BUILT SKETCH

1"=40'

Permit can be suspended or revoked if any false information is supplied toward securing the permit / any unauthorized changes are made to the site / any unauthorized changes are made in the installation of the system. **CONTACT A LOCATOR SERVICE PRIOR TO ANY EXCAVATION**

☐ **IMPROVEMENT PERMIT** *with plat valid without expiration* ☐ **IMPROVEMENT PERMIT** *with site plan valid for 60 mos.* ☒ **AUTHORIZATION TO CONSTRUCT** *valid for period equal to IMPROVEMENT PERMIT--not to exceed 60 mo.*

Owner / Applicant Signature: Date: Installed by: ROWAN SEPTIC TANK

IMPROVEMENT PERMIT by: Date: 9-4-13 OPERATION PERMIT by: Date: 9-5-13

AUTHORIZATION TO CONSTRUCT by: Date: 9-4-13 Existing System Inspected by: Date:

Health Dept. Copy - WHITE Applicant (Final Approval) - YELLOW Applicant (Conditional Approval) - PINK