4100

IREDELL COUNTY HEALTH DEPARTMENT

STATESVILLE 704-878-5305 MOORESVILLE 704-664-5281

IMPROVEMENT PERMIT / AUTHORIZATION TO CONSTRUCT / OPERATION PERMIT / EXISTING SYSTEM INSPECTION

PERMIT# 148942 PIN# 4626003012 DATE 5-22-08

OWNER OR APPLICANT Mid-Atlantic Custom builders/Capote Bch PHONE: Business 828-478-2761 Home

ADDRESS Po Box 3792 Mooresville NC 28117

LOCATION Brawley School Rd, TR Chuckwood, TL Barber, on R

SUBDIVISION Waterfree Landing BLOCK / SECTION 4 LOT 79 LOT AREA .73 SITE CLASS. PS DESIGN FLOW 480 L.T.A.R. .3

Septic Tank: 1000 Gallons: STB 766 Date 4-22-14

Pump Tank: 1000 Gallons: PT 363 Date 3-28-14

Pump Make: Model Serial No.

Nitrification Field: No Fields 1 Square Feet 1200' Linear Feet 400'

No Lines 3 Trench Width 36" Max Trench Bottom Depth 36" Gravel Depth —

☒ New System ☐ Repair ☐ Expansion System Type: I II III IV V VI

System Description: PM 25%

Repair System Description: LP PPBPS

Maintenance Agreement Required: ☐ Yes ☒ No Initially

☒ House/Mod. Home ☐ Mobile Home ☐ Business ☐ Other

No. Bedrooms 4 No. Persons 8 No. Employees

Water Supply: ☒ Individual ☐ Public ☐ Community

☐ Gravity ☒ Pressure ☐ Slab ☒ Crawl Space ☐ Basement w/plumbing ☐ Basement wo/plumbing

Comments:/Conditions: ST 8FT from Garage & 7FT from Side of house

Comments:/Conditions: Ashley Rollans Okayed to do 4-100FT lines & used Quick 4 6/26/14 Checked tanks & lines.

INITIAL SITE SKETCH

SEE Plan From Rollans Soil + Environmental Services

AS BUILT SKETCH

Permit can be suspended or revoked if any false information is supplied toward securing the permit/any unauthorized changes are made to the site/any unauthorized changes are made in the installation of the system. Improvement Permit with plat valid without expiration ☐ Improvement Permit with site plan valid for sixty months ☒ Authorization to Construct is valid for a period equal to that of Improvement Permit – not to exceed sixty months.

Signed: date

Improvement Permit by: date 5-22-08

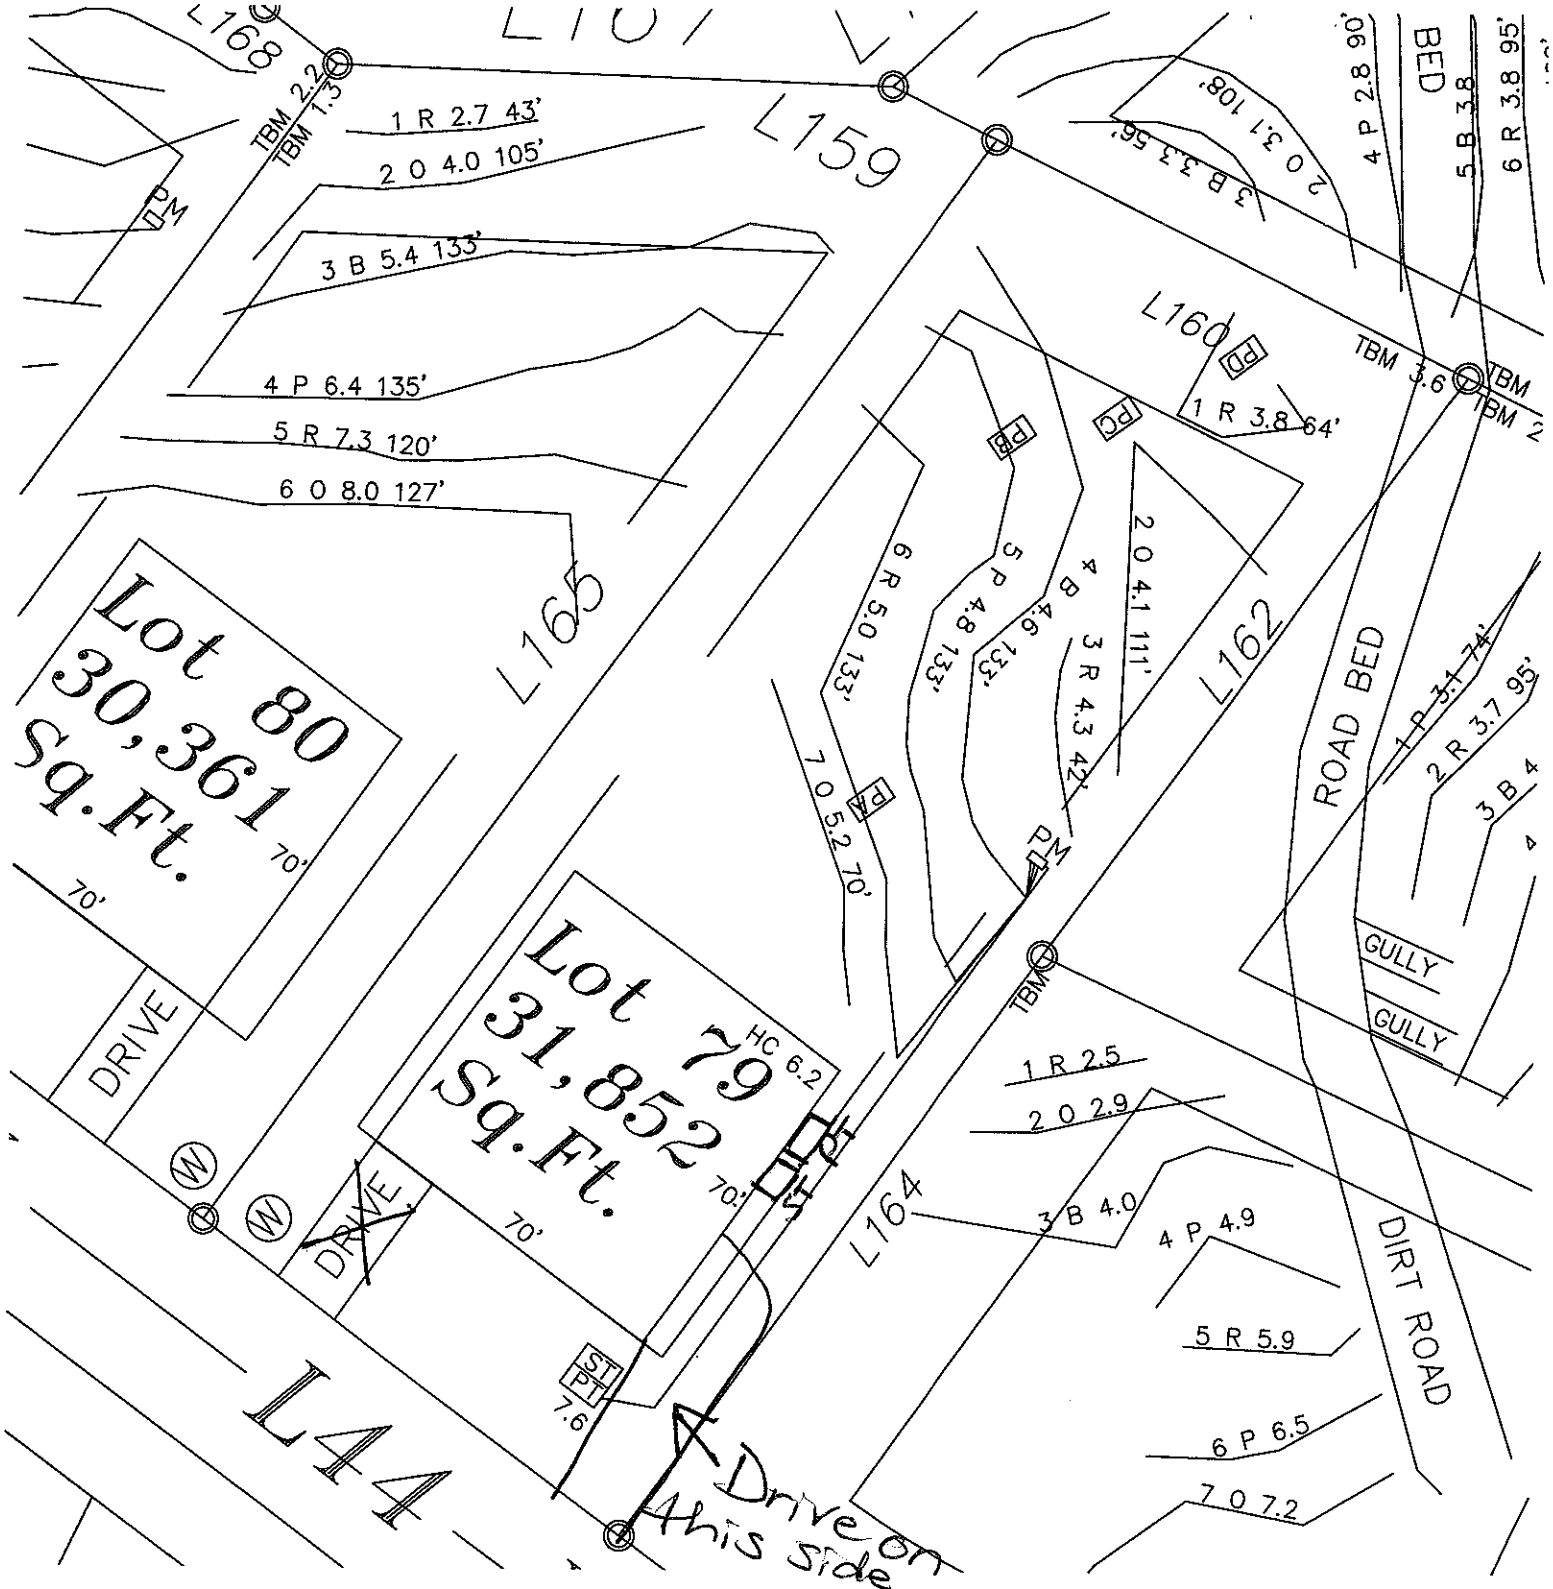
Authorization to Construct by: date 5-22-08

Installed by: Gunter Grading

Operation Permit by: date 7/31/14

Existing System Inspection by: date

HEALTH DEPT. COPY: WHITE OWNER COPY (FINAL): YELLOW OWNER COPY (INITIAL): PINK


L168
L159
L160
L165
L162
L164
L44
TBM 2.2
TBM 1.3
1 R 2.7 43'
2 O 4.0 105'
3 B 5.4 133'
4 P 6.4 135'
5 R 7.3 120'
6 O 8.0 127'
Lot 80
30,361
Sq.Ft.
70'
70'
Lot 79
31,852
Sq.Ft.
70'
70'
HC 6.2
DRIVE
DRIVE
DRIVE
TBM
TBM 3.6
1 R 3.8 64'
6 R 5.0 133'
5 P 4.8 133'
4 B 4.6 133'
3 R 4.3 42'
2 O 4.1 111'
7 O 5.2 70'
ROAD BED
4 P 3.1 74'
2 R 3.7 95'
3 B 4
GULLY
GULLY
1 R 2.5
2 O 2.9
3 B 4.0
4 P 4.9
5 R 5.9
6 P 6.5
7 O 7.2
DIRT ROAD
4 P 2.8 90'
5 B 3.8
6 R 3.8 95'
2 O 3.1 108'
3 B 3.3 56'
7.6
A Drive on this Side