IREDELL COUNTY HEALTH DEPARTMENT

STATESVILLE 704-878-5305 MOORESVILLE 704-664-5281

IMPROVEMENT PERMIT / AUTHORIZATION TO CONSTRUCT / OPERATION PERMIT / EXISTING SYSTEM INSPECTION

PERMIT # 14896214892 6 PIN # 4626005159 DATE 12/4/12

OWNER or APPLICANT LAKE LUXURY HOMES PHONE: Business Home: 704 516 2344

OWNER or APPLICANT ADDRESS PO BOX 3972 MOORESVILLE NC 28117

LOCATION / DIRECTIONS BRAWLEY SCHOOL - TR CHUCKWOOD - TL 1ST BARBER LOOP - ON RT

SUBDIVISION WATER TREE LANDING BLOCK / SECTION LOT # 76 LOT AREA .7AC DESIGN FLOW 480GPD L.T.A.R. .36PD/FT²

Septic Tank 1000 Gallons: STB 1194 Date 1-7-13

Pump Tank Gallons: P T Date

Pump Make Model Serial #

Nitrification Field No Fields 1 No Lines 5 Linear Feet 400

Trench Width 36" Max. Trench Bottom Depth 36" Gravel Depth N/A

☑ New System ☐ Repair ☐ Expansion System Type I II (III) IV V VI

System Description: GRAVITY 25% REDUCTION

Repair System Description: LP PIPES

Maintenance Agreement Required ☐ YES ☑ NO

☑ GRAVITY ☐ PRESSURE

☑ Residence No. Bedrooms 4

☐ Business No. Persons 8

☐ Other No. Employees

☐ Slab ☑ Crawl Space

☐ Basement w/plumbing ☐ Basement w/o plumbing


Water Supply: ☑ Private ☐ Public ☐ Community

Comments / Conditions KEEP WELL 50' FROM NEIGHBOR'S SEPTIC.


1"=50'

Comments / Conditions 4/3/13 Installed Quick 4 Checked tank & lines in Compliance OK to Cover MK

INITIAL SITE SKETCH

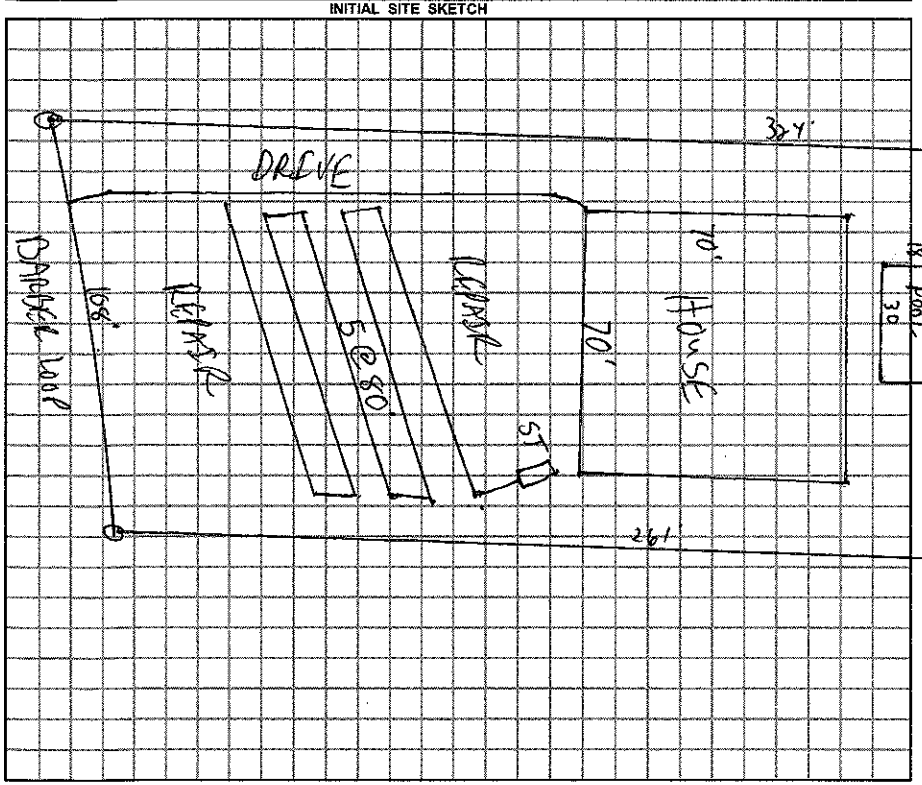

AS BUILT SKETCH

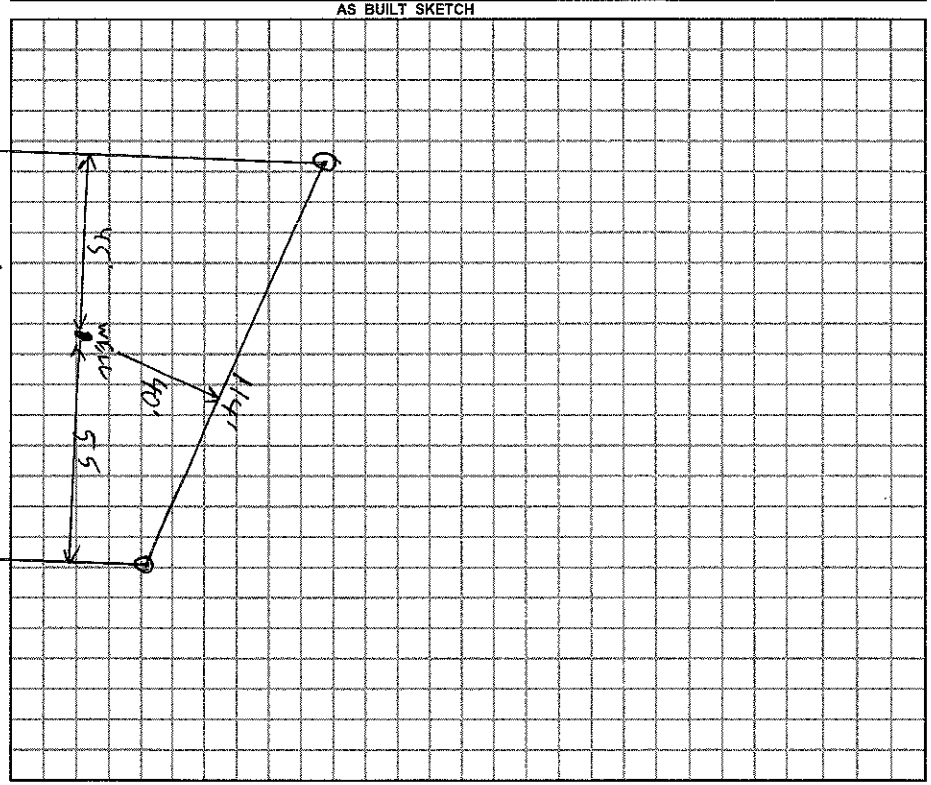

Permit can be suspended or revoked if any false information is supplied toward securing the permit / any unauthorized changes are made to the site / any unauthorized changes are made in the installation of the system.

☐ *IMPROVEMENT PERMIT w / plat valid without expiration.* ☑ *IMPROVEMENT PERMIT w / site plan valid for 60 mos.* ☐ *AUTHORIZATION TO CONSTRUCT valid for period equal to IMPROVEMENT PERMIT-not to exceed 60 mo.*

Owner / Applicant Signature: Date 12/18/12

Improvement Permit by: C. Brady Thompson REHS Date 12/4/12

Authorization to Construct by: C. Brady Thompson REHS Date 12/18/12

Installed by: Wastewater Solutions

Operation Permit by: Mandy Hall BS Date: 4/3/13

Existing System Inspected by: Date:

YOU SHOULD CONTACT A LOCATOR SERVICE PRIOR TO ANY EXCAVATION.

WHITE COPY Environmental Health YELLOW COPY (Final) Owner / Applicant PINK COPY (Initial) Owner / Applicant