205015

IREDELL COUNTY HEALTH DEPARTMENT

STATESVILLE 704-878-5305 MOORESVILLE 704-664-5281

IMPROVEMENT PERMIT / AUTHORIZATION TO CONSTRUCT / OPERATION PERMIT / EXISTING SYSTEM INSPECTION

PERMIT # ~~14~~ 205015 PIN # 4626-00-6630 DATE 3-17-09

OWNER or APPLICANT MID ATLANTIC CUSTOM [illegible] BUILDERS PHONE: Business 828-478-2761 Home:

OWNER or APPLICANT ADDRESS PO BOX 3792 MOORESVILLE 28117

LOCATION / DIRECTIONS BSR, TR CHUCKWOOD, TL BARBER, ON L

SUBDIVISION WATERTREE LANDING BLOCK / SECTION LOT # 64 LOT AREA .69 AC DESIGN FLOW 480 L.T.A.R. .3

Septic Tank 1000 Gallons: STB 825 Date 3-12-14

Pump Tank Gallons: P T Date

Pump Make Model Serial #

Nitrification Field No Fields 1 No Lines 3 Linear Feet 400

Trench Width 36" Max. Trench Bottom Depth 36" Gravel Depth —

☒ New System ☐ Repair ☐ Expansion System Type I (II) III IV V VI

System Description: GRAVITY 25% REDUCTION

Repair System Description: LP - PANEL BLOCK

Maintenance Agreement Required ☐ YES ☒ NO INITIALLY

☒ GRAVITY ☐ PRESSURE

☒ Residence No. Bedrooms 4

☐ Business No. Persons

☐ Other No. Employees

☐ Slab ☒ Crawl Space

☐ Basement w/plumbing ☐ Basement w/o plumbing

Water Supply: ☒ Private ☐ Public ☐ Community


Comments / Conditions * INSTALL PER PLAN SPECS *

Comments / Conditions

INITIAL SITE SKETCH

SEE ATTACHED PLAN BY ROLLANS SOIL + ENVIRONMENTAL SERVICES

AS BUILT SKETCH

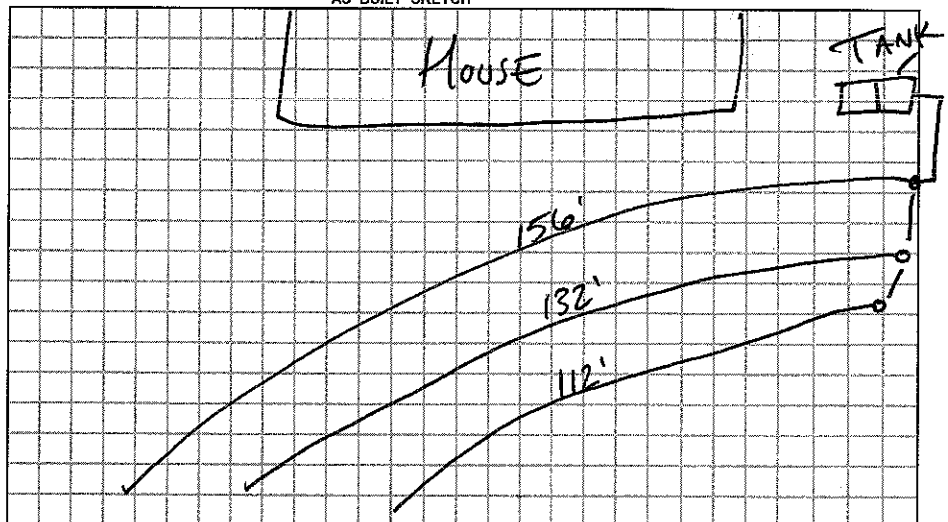

The proposed / existing POOL addition does not appear to impact the existing septic system.

**NOTE: KEEP POOL EDGE 15' FROM SEPTIC

Permit # 205015

R.S.

Date: 5/1/14

ICHD-Environmental Health Division

Permit can be suspended or revoked if any false information is supplied toward securing the permit / any unauthorized changes are made to the site / any unauthorized changes are made in the installation of the system.

☐ *IMPROVEMENT PERMIT w / plat valid without expiration.* ☐ *IMPROVEMENT PERMIT w / site plan valid for 60 mos.* ☒ *AUTHORIZATION TO CONSTRUCT valid for period equal to IMPROVEMENT PERMIT-not to exceed 60 mo.*

Owner / Applicant Signature: Date 05/13/09

Improvement Permit by: Date 3-17-09

Authorization to Construct by: Date 3-17-09

YOU SHOULD CONTACT A LOCATOR SERVICE PRIOR TO ANY EXCAVATION.

Installed by: ROWAN SEPTIC

Operation Permit by: APPROVED MAY 07 2014

Existing System Inspected by: Date:

WHITE COPY Environmental Health YELLOW COPY (Final) Owner / Applicant PINK COPY (Initial) Owner / Applicant