3:30 pm

IREDELL COUNTY HEALTH DEPARTMENT

STATESVILLE 704-878-5305 MOORESVILLE 704-664-5281

IMPROVEMENT PERMIT / AUTHORIZATION TO CONSTRUCT / OPERATION PERMIT / EXISTING SYSTEM INSPECTION

PERMIT # 1606102 PIN # 4626007069 DATE 5-20-11

OWNER or APPLICANT Ronnie Terry PHONE: Business # 7048573921 Home: 704239-0846

OWNER or APPLICANT ADDRESS 604 Frontier Circle China Grove NC 28023

LOCATION / DIRECTIONS Brawley School Rd TR Chickwood TL Barber Lp on left #275

SUBDIVISION Cust BLOCK / SECTION 7 LOT # 146 LOT AREA 1.68Ac DESIGN FLOW 360 L.T.A.R. .3

Septic Tank 1000 Gallons: STB 825 Date 7-12-11
Pump Tank Gallons: PT Date
Pump Make Model Serial #
Nitrification Field No Fields 1 No Lines 4 Linear Feet 190-200'
Trench Width 24" Max. Trench Bottom Depth 30" Gravel Depth N/A

☒ New System ☐ Repair ☐ Expansion System Type I II III IV V VI
System Description: Gravity - 50% Reduction
Repair System Description: Pump - 25-50% Reduct
Maintenance Agreement Required ☐ YES ☐ NO
☒ GRAVITY ☐ PRESSURE


☒ Residence No. Bedrooms 3
☐ Business No. Persons
☐ Other No. Employees
☐ Slab ☐ Crawl Space
☐ Basement w/plumbing ☐ Basement w/o plumbing

Water Supply
☒ Private Exist
☐ Public
☐ Community


Comments / Conditions: Plumb out plumbing high. Must keep Septic System at least 5Ft from House, 50Ft from well & 50Ft from lake. Drainlines 5Ft from PL

Comments / Conditions: Very tight fit on Septic System. Set house 36Ft. From front PL. Do Not place Drive over Septic System.

INITIAL SITE SKETCH

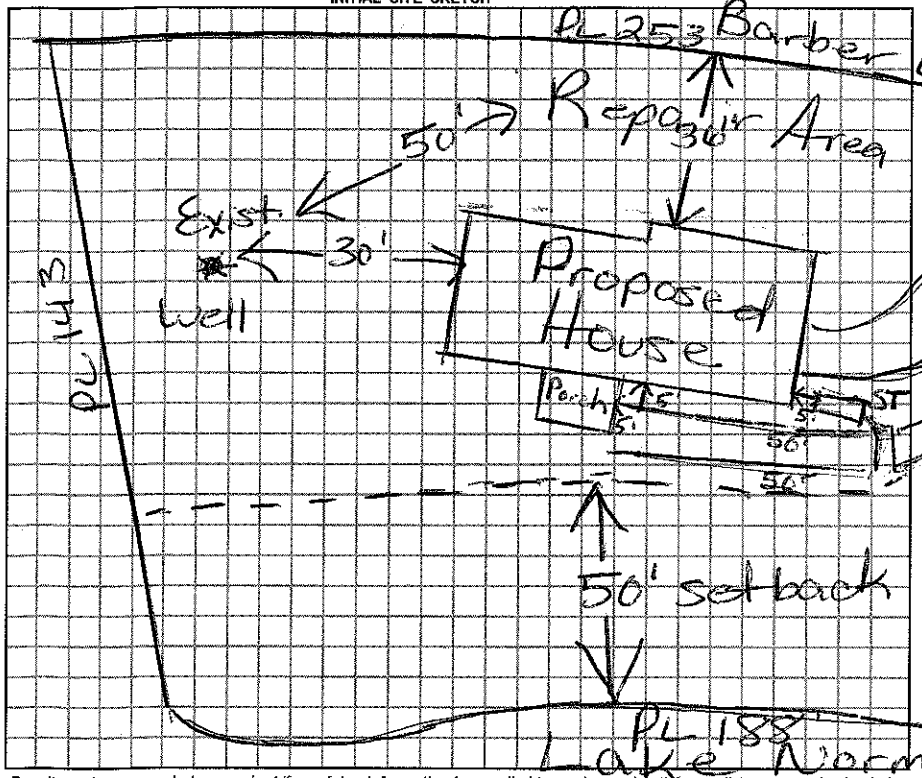

AS BUILT SKETCH

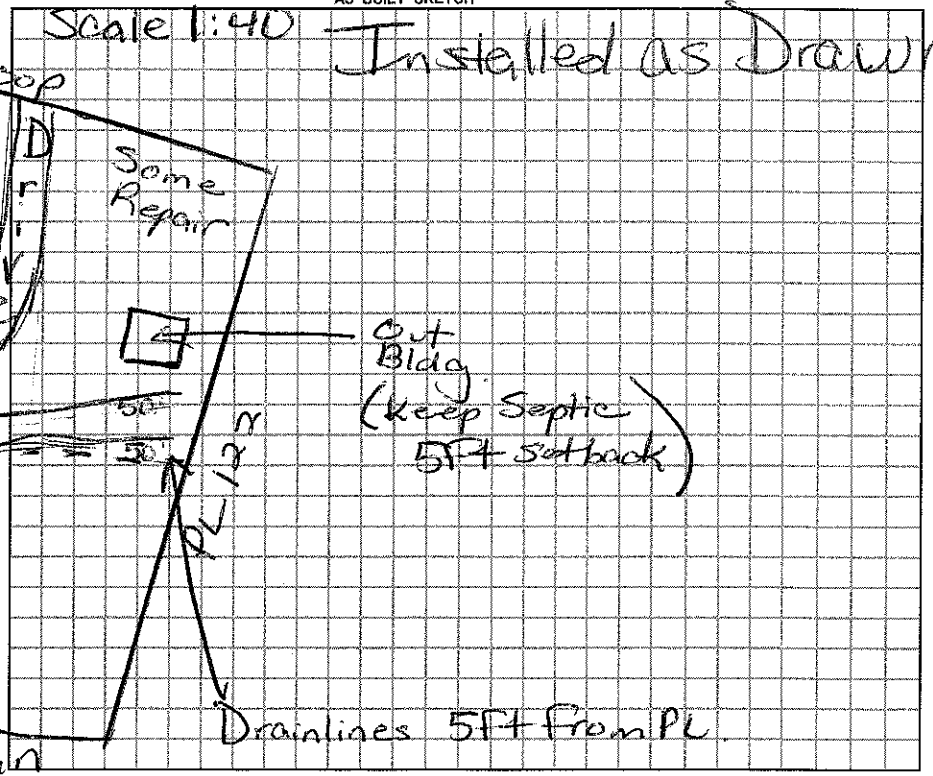

Permit can be suspended or revoked if any false information is supplied toward securing the permit / any unauthorized changes are made to the site / any unauthorized changes are made in the installation of the system.

☐ *IMPROVEMENT PERMIT w / plat valid without expiration* ☐ *IMPROVEMENT PERMIT w / site plan valid for 60 mos.* ☐ *AUTHORIZATION TO CONSTRUCT valid for period equal to IMPROVEMENT PERMIT-not to exceed 60 mo.*

Owner / Applicant Signature: Michael Ronnie Terry Date 5/29/11

Improvement Permit by: Maina H. Dotson REHS Date 5/20/11

Authorization to Construct by: Maina H. Dotson Date 5/20/11

Installed by: Rowan Septic RS

Operation Permit by: Maina H. Dotson Date: 9/20/11

Existing System Inspected by: Date:

YOU SHOULD CONTACT A LOCATOR SERVICE PRIOR TO ANY EXCAVATION.

WHITE COPY Environmental Health YELLOW COPY (Final) Owner / Applicant PINK COPY (Initial) Owner / Applicant