IREDELL COUNTY HEALTH DEPARTMENT

Statesville Office (704) 878-5305 Mooresville Office (704) 660-3625

PERMIT # 148870

IMPROVEMENT PERMIT / AUTHORIZATION TO CONSTRUCT / OPERATION PERMIT / EXISTING SYSTEM

PIN # 4607600-8712

APPLICANT: LAKE LUXURY HOMES APPLICANT ADDRESS: PO BOX 3792 MVILLE

SITE ADDRESS: 574 BARBER LOOP PHONE: 704-510-2344 ALT. PHONE:

SITE DIRECTIONS: BSR, CHUCKWOOD, TL BARBER ON R

SUBDIVISION: WATERTREE LANDING SECTION: LOT # 65 LOT AREA: .69 AC DESIGN FLOW: 360 L.T.A.R.: 275

Septic Tank 1000 (gal) STB 825 Date 1-27-14
Pump Tank (gal) PT Date
Pump Make Model Serial #
Nitrification Fields 1 # Lines 3 @ 109' Linear Ft: 327'
Trench Width 36" Max. Trench Bottom Depth 36" Gravel Depth —


☒ New System ☐ Repair ☐ Expansion System Type: I II ☒ III IV V VI
System Description: 25% REDUCTION
Repair System Description: PANEL
Maintenance Agreement Required: ☐ YES ☒ NO
☒ GRAVITY ☐ PRESSURE

☒ Residence No. Bedrooms 3
☐ Business No. Persons
☐ Other No. Employees
☐ Slab ☒ Crawl Space
☐ Basement w/plumbing ☐ Basement w/o plumbing

Water Supply: ☒ Private ☐ Public ☐ Community

Comments / Conditions:

INITIAL SITE SKETCH

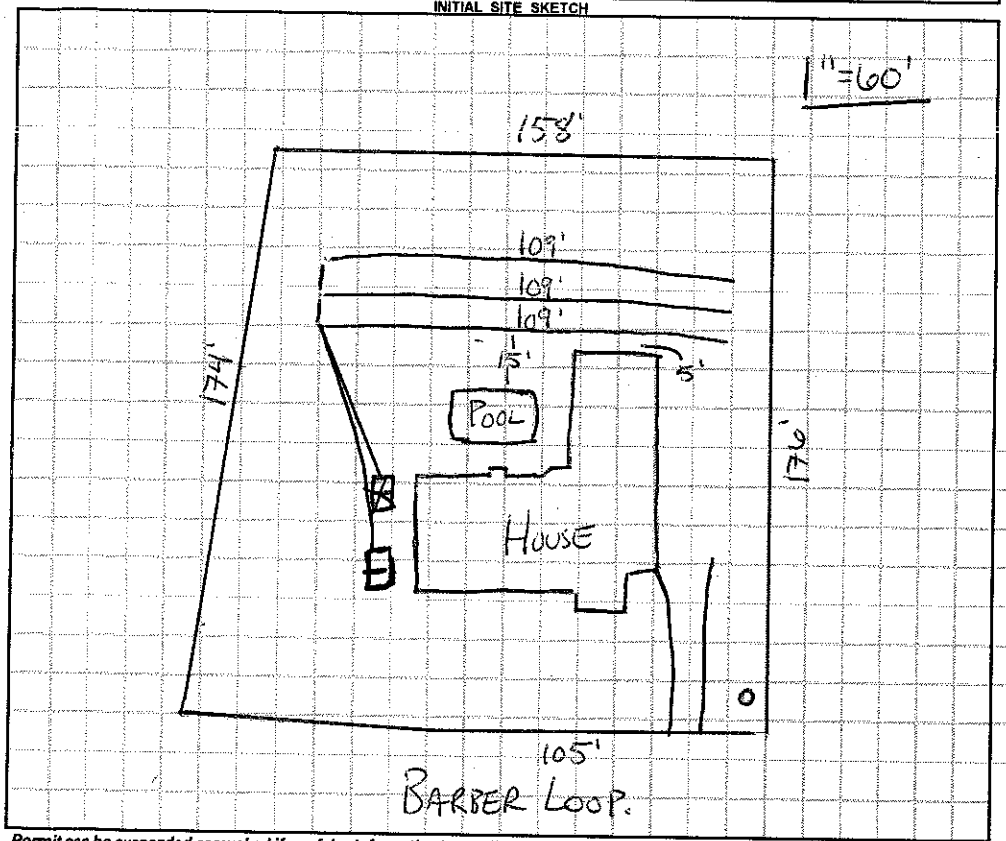

AS BUILT SKETCH

27 CM PER DITCH

TANKS & LINES

CHECKED MAR 13 2014

The proposed / existing POOL addition does not appear to impact the existing septic system.
**NOTE: WATER MUST BE 5' FROM SEPTIC

R.S.

Date: APPROVED JUN 25 2014
ICHD-Environmental Health Division

Permit can be suspended or revoked if any false information is supplied toward securing the permit / any unauthorized changes are made to the site / any unauthorized changes are made in the installation of the system. **CONTACT A LOCATOR SERVICE PRIOR TO ANY EXCAVATION**

☐ **IMPROVEMENT PERMIT** *with plat valid without expiration.* ☒ **IMPROVEMENT PERMIT** *with site plan valid for 60 mos.* ☐ **AUTHORIZATION TO CONSTRUCT** *valid for period equal to IMPROVEMENT PERMIT--not to exceed 60 mo.*

Owner / Applicant Signature: Date: 2-19-14 Installed by: KOWAN SEPTIC

IMPROVEMENT PERMIT by: Date: 2-4-14 OPERATION PERMIT by: APPROVED MAR 13 2014

AUTHORIZATION TO CONSTRUCT by: APPROVED FEB 24 2014 Date: Existing System Inspected by: Date:

Health Dept. Copy - WHITE Applicant (Final Approval) - YELLOW Applicant (Conditional Approval) - PINK