IREDELL COUNTY HEALTH DEPARTMENT

STATESVILLE 704-878-5305 ~~MOORESVILLE~~ 704-664-5281

IMPROVEMENT PERMIT / AUTHORIZATION TO CONSTRUCT / OPERATION PERMIT / EXISTING SYSTEM INSPECTION

PERMIT # 148889 PIN # 4626-00-9597 DATE 9-27-12

OWNER or APPLICANT LAKE LUXURY HOMES PHONE: Business 704-516-2344 Home:

OWNER or APPLICANT ADDRESS PO BOX 3792 MOORESVILLE NC

LOCATION / DIRECTIONS BSR, TR CHUCKWOOD, TL BARBER, ON R

SUBDIVISION WATER TREE LANDING BLOCK / SECTION LOT # 72 LOT AREA .169 AC DESIGN FLOW 480 L.T.A.R. .3/.25(R)

Septic Tank 600 Gallons: STB 794 Date 11-3-12
Pump Tank Gallons: P.T Date
Pump Make Model Serial #
Nitrification Field No Fields 1 No Lines 5 Linear Feet 400'
Trench Width 36" Max. Trench Bottom Depth 36" Gravel Depth —

☒ New System ☐ Repair ☐ Expansion System Type I II (III) IV V VI
System Description: 25% REDUCTION
Repair System Description: PANEL
Maintenance Agreement Required ☐ YES ☒ NO
☒ GRAVITY ☐ PRESSURE


☒ Residence No. Bedrooms 4
☐ Business No. Persons
☐ Other No. Employees
☐ Slab ☒ Crawl Space
☐ Basement w/plumbing ☐ Basement w/o plumbing

Water Supply: ☒ Private ☐ Public ☐ Community

Comments / Conditions

Comments / Conditions

INITIAL SITE SKETCH

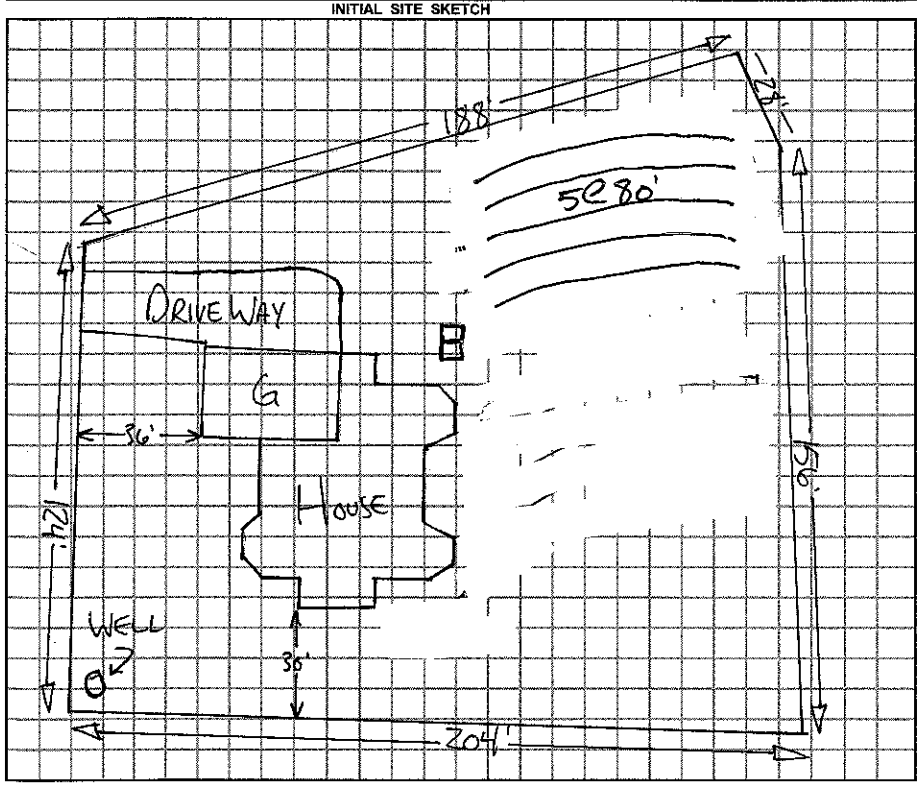

AS BUILT SKETCH

HIT SMALL AMOUNT HARD ROCK ON LAST LINE. SYSTEM INSTALLED IN REPAIR AREA BUT SOIL OK @ 3

Permit can be suspended or revoked if any false information is supplied toward securing the permit / any unauthorized changes are made to the site / any unauthorized changes are made in the installation of the system.

☐ *IMPROVEMENT PERMIT w / plat valid without expiration.* ☐ *IMPROVEMENT PERMIT w / site plan valid for 60 mos.* ☑ *AUTHORIZATION TO CONSTRUCT valid for period equal to IMPROVEMENT PERMIT-not to exceed 60 mo.*

Owner / Applicant Signature: Date 10/9/12 Installed by: WASTEWATER SOLUTIONS

Improvement Permit by: REHS Date 9-28-12 Operation Permit by: Date: 12-19-12

Authorzation to Construct by: REHS Date 10-9-12 Existing System Inspected by: Date:

YOU SHOULD CONTACT A LOCATOR SERVICE PRIOR TO ANY EXCAVATION.

WHITE COPY Environmental Health YELLOW ~~COPY~~ (Final) Owner / Applicant PINK COPY (Initial) Owner / Applicant