IREDELL COUNTY HEALTH DEPARTMENT

STATESVILLE 704-878-5305 MOORESVILLE 704-664-5281

IMPROVEMENT PERMIT / CERTIFICATE OF COMPLETION / OPERATION PERMIT / EXISTING SYSTEM INSPECTION

~~(10:00)~~ - (4:00)

PROPERTY DESCRIPTION NO. 17379 DATE Feb 18, '94 TAX MAP NO. 2E 1A 72 / 4626012-83 Watershed: ☑ Yes ☐ No

OWNER OR CONTRACTOR IRVIN McMANUS PHONE: Business _____ Home 392-5432 LN

ADDRESS 9016 Longview DR, Charlotte

LOCATION 1100 TR 1177 to End TL Barber Loop TR Larkhaven on left in curve

SUBDIVISION Crescent LN BLOCK / SECTION 7 LOT 72 LOT AREA ½-¾ Ac SITE CLASS PSp 11956 DESIGN FLOW 480 gpd L.T.A.R. .03

Septic Tank: 1000 Gallons; STB 794 Date 10-8-96

Pump Tank: _____ Gallons; PT _____ Date _____

Pump Make: _____ Model _____ Serial No. _____

Nitrification Field: No Fields 2 Square Feet _____ Linear Feet 200

No Lines 5 Trench Width 24" Max Trench Bottom Depth 36" Gravel Depth N/A

☑ New System ☐ Repair System Type: I, II, III, IV, V, VI

System Description: gravity PTBPS

Repair System Description: LPJPBPS

Maintenance Agreement Required: ☐ Yes ☑ No

☑ House/Mod/Home No. Bedrooms 4

☐ Mobile Home No. Bathrooms 3½

☐ Business No. Employees _____

☐ Other _____


☐ Slab ☑ Crawl Space ☑ Basement w/plumbing ☐ Basement wo/plumbing

Water Supply: ☑ Individual ☐ Community ☐ Public


Comments: Basement level plumbing to go to existing system add well to be properly abandoned while HII representative on site

Comments: LOWER 3 LINES CHECKED 12/16/96

INITIAL SITE SKETCH

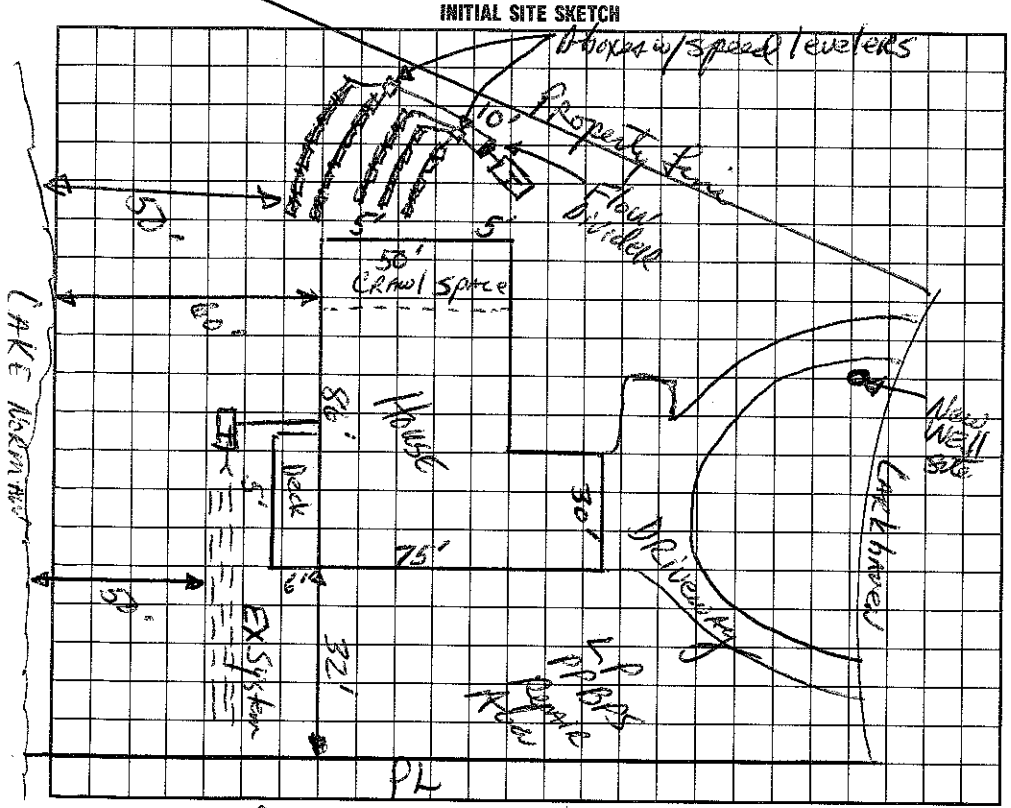

AS BUILT SKETCH

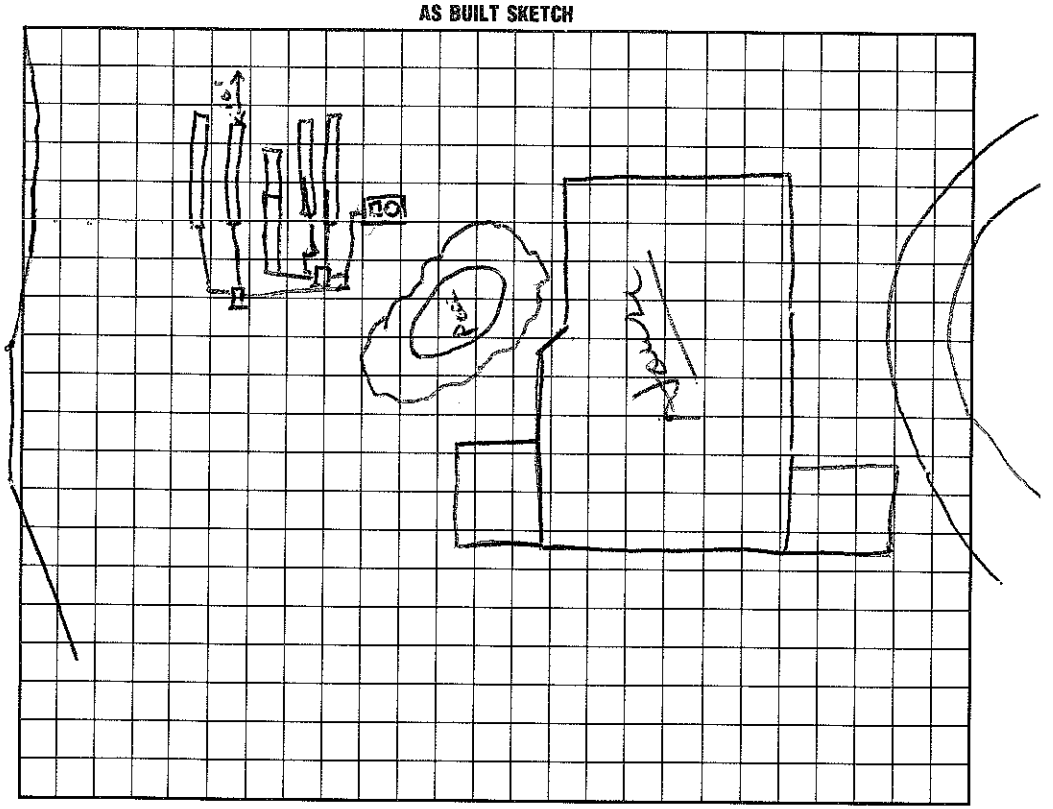

I understand that this permit can be suspended or revoked if any false information is supplied toward securing the permit/any unauthorized changes are made to the site/any unauthorized changes are made in the installation of the system. Improvement Permit is valid for 60 months from date of issuance.

Signed: _____

Improvement Permit by: _____, RS date 2/18/94

Existing System Inspection by: _____ date _____

Installed by: Barry Thompson

Certificate of Completion by: _____ date _____

Operation Permit by: Wesley Sparks RS date 12/16/96

HEALTH DEPT. COPY: WHITE INSPECTION COPY (FINAL): GREEN OWNER COPY (FINAL): YELLOW INSPECTION COPY (INITIAL): PINK OWNER COPY (INITIAL): GOLD