IREDELL COUNTY HEALTH DEPARTMENT

STATESVILLE 704-878-5305 MOORESVILLE 704-664-5281

IMPROVEMENT PERMIT / AUTHORIZATION TO CONSTRUCT / OPERATION PERMIT / EXISTING SYSTEM INSPECTION

PERMIT# 122130 PIN# 4626 01 3494 DATE 8/2/04

OWNER OR CONTRACTOR Steven Seeley / Vista Signature Homes PHONE: Business 980-722-9535 Home

ADDRESS 107 Beachview Drive Mooresville, NC. 28117

LOCATION 134 Lakhaven Lane 1100 TR Churchwood TL Berkshop TR Lakhaven on (L)

SUBDIVISION CL+T BLOCK / SECTION 7 LOT 70 LOT AREA ~ 1.6 AC SITE CLASS PS DESIGN FLOW 480 L.T.A.R. .3

Septic Tank: 1000 Gallons; STB 1007 Date 2/8/06
Pump Tank: 1000 Gallons; PT 274 Date 1/8/07
Pump Make: Zoeller Model PE51M Serial No.
Nitrification Field: No. Fields 1 Square Feet 532/798 Linear Feet 266
No. Lines 3&4 Trench Width 2-3 Max. Trench Bottom Depth 3' Gravel Depth No

[X] New System [ ] Repair System Type: I, II, III, [IV], V, VI
System Description: Pre-Dosed - 16" PRBPS
Repair System Description: < 1983
Maintenance Agreement Required: [X] Yes [ ] No


[X] House/Mod. Home No. Bedrooms 4
[ ] Mobile Home No. Bathrooms 3
[ ] Business No. Employees
[ ] Other 1/2
[X] Slab [ ] Crawl Space [X] Basement w/plumbing [ ] Basement wo/plumbing

Water Supply: [X] Individual [ ] Public [ ] Community

Comments/Conditions: Old well Must be properly abandoned. See New Well Location.

Comments/Conditions: 47, 70, 75, 75, 269 Tanks, Pressure, Drainlines

INITIAL SITE SKETCH (1"=40')

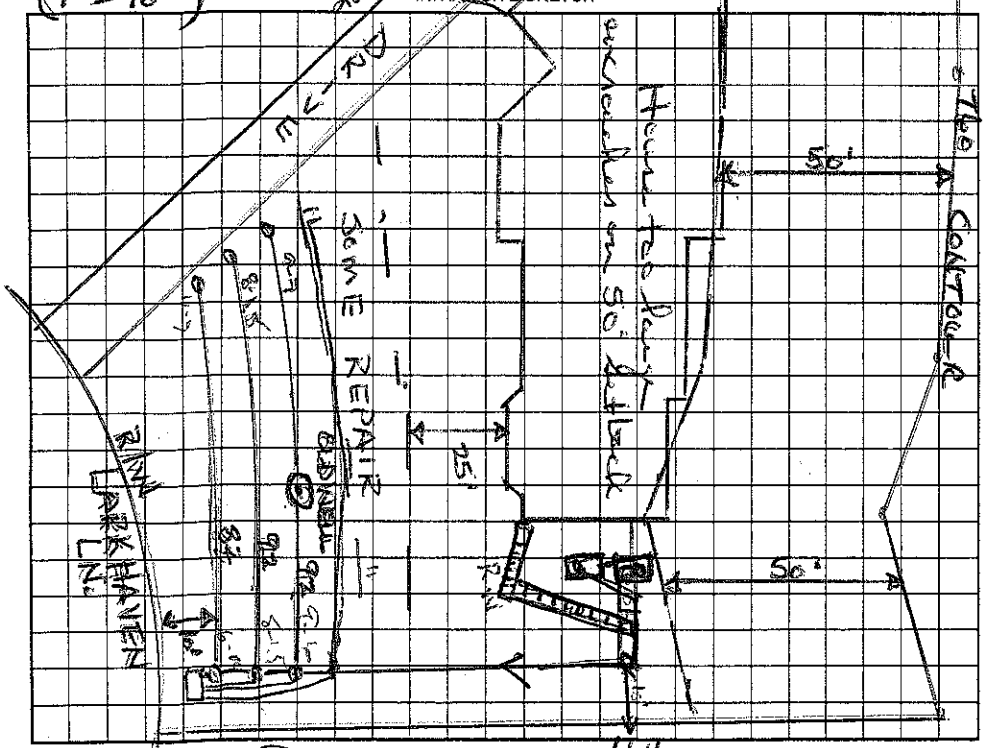

AS BUILT SKETCH

Permit can be suspended or revoked if any false information is supplied toward securing the permit/any unauthorized changes are made to the site/any unauthorized changes are made in the installation of the system. Improvement Permit with plat valid without expiration. Improvement Permit with site plan valid for sixty months. Authorization to Construct is valid for a period equal to that of Improvement Permit – not to exceed sixty months.

Signed: X date 8/25/04 Installed by:

Improvement Permit by: Wesley Sparks R.S. date 8/2/04 Operation Permit by: Wesley Sparks R.S. date 3/20/07

Authorization to Construct by: Wesley Sparks R.S. date 7/22/05 Existing System Inspection by: date

HEALTH DEPT. COPY: WHITE OWNER COPY (FINAL): YELLOW OWNER COPY (INITIAL): PINK