IREDELL COUNTY HEALTH DEPARTMENT

STATESVILLE 704-878-5305 MOORESVILLE 704-664-5281

IMPROVEMENT PERMIT / CERTIFICATE OF COMPLETION / OPERATION PERMIT / EXISTING SYSTEM INSPEC.

PROPERTY DESCRIPTION NO. 21195 DATE Nov. 8, 195 TAX MAP NO. parcel 2FA8 Watershed: ☑ Yes ☐ No

OWNER OR CONTRACTOR Bryan Baker PHONE: Business ~~Business~~ Home 663-2777 U54CA

ADDRESS 205 Isle of Pines Rd, Mooresville

LOCATION Brawley School Road TR Chickenwood TR (extend) on Barber Loop TR Larkhaven 4626-01-5236


SUBDIVISION Fairchase Pointe BLOCK / SECTION ____ LOT 1 LOT AREA .5Ac SITE CLASS Apr. 1996 DESIGN FLOW 360gpd L.T.A.R. .3

Septic Tank: 1000 Gallons; STB 794 Date ____	☑ New System ☐ Repair System Type: I, II, III, IV, V, VI	☑ House/Mod. Home No. Bedrooms 3	Water Supply:
Pump Tank: ____ Gallons; PT ____ Date ____	System Description: gravity Infiltrator	☐ Mobile Home No. Bathrooms 2½	☑ Individual
Pump Make: ____ Model ____ Serial No. ____	Repair System Description: gravity pond blocks	☐ Business No. Employees ____	☐ Community
Nitrification Field: No Fields 1 Square Feet 900 Linear Feet 300	Maintenance Agreement Required: ☐ Yes ☑ No	☐ Other ____	☐ Public
No Lines ~~3~~ 3 + 3 Trench Width 36" Max Trench Bottom Depth 30" Gravel Depth NA	☐ Slab ☑ Crawl Space ☐ Basement w/plumbing ☐ Basement wo/plumbing		

Comments: Distribution system consists of Flow Divider to 2 D-boxes w/ speed levelers.

Comments:

INITIAL SITE SKETCH

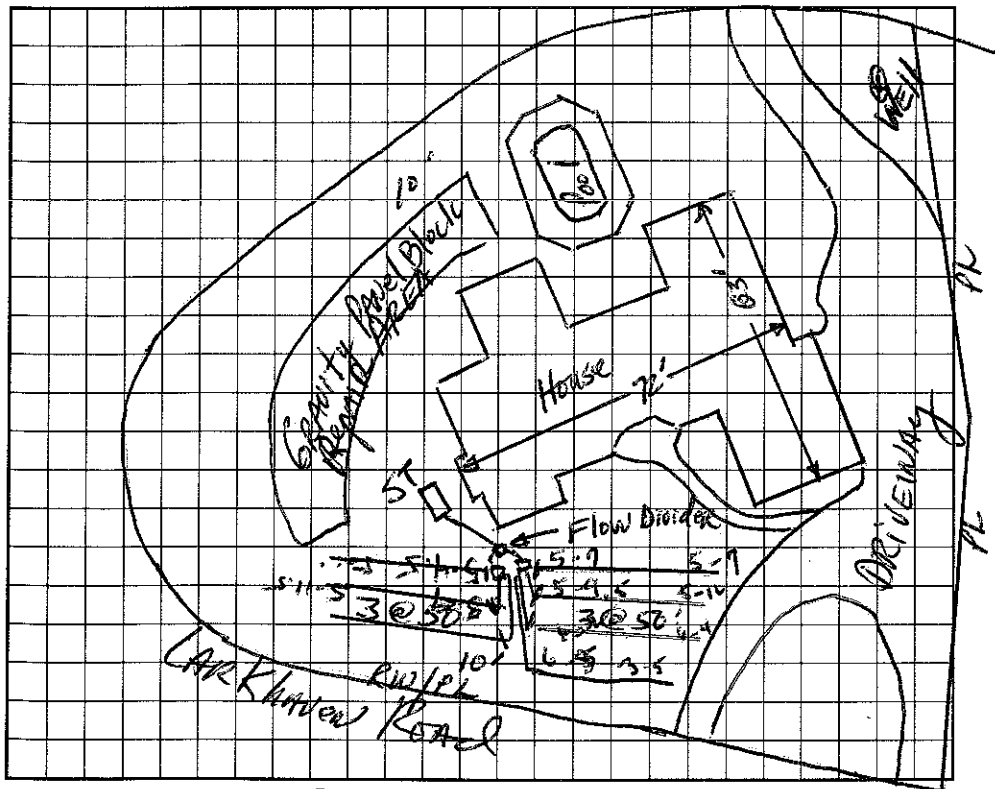

AS BUILT SKETCH

I understand that this permit can be suspended or revoked if any false information is supplied toward securing the permit/any unauthorized changes are made to the site/any unauthorized changes are made in the installation of the system.

Signed: ____

Improvement Permit by: David R. Hanson, RS date 11-8-95

Authorization to construct

Existing System Inspection by: David R. Hanson, RS date 11-8-95

Installed by: Barry Thompson

Certificate of Completion by: ____ date ____

Operation Permit by: Wendy Sparks R.S. date 11/14/96

HEALTH DEPT. COPY: WHITE INSPECTION COPY (FINAL): GREEN OWNER COPY (FINAL): YELLOW INSPECTION COPY (INITIAL): PINK OWNER COPY (INITIAL): GOLD