[redacted]ELL COUNTY HEALTH DEPARTMENT

Statesville Phone TR [redacted]-7271 Mooresville Phone NO 3-1271

PERMIT TO INSTALL SEPTIC TANK

Permit NO. _____ Permit Date 23 July 1965

Owner R. F. Barger Address Freens Boro N.C.

Installed By Carl Dockery Address Mooresville, NC


Location of Property Sect 4 Lot 69

Tank		Capacity		Length of Lines		Fixtures	
Block	(✓)	800	( )	150'	( )	No. of Baths	( )
Precast	( )	900	( )	175'	( )	Dishwasher	( )
		1000	(✓)	200'	( )	Garbage Grdr.	( )
		1100	( )	225'	(✓)	Auto-Washer	( )
		1200	( )	250'	( )	Other	
		Other		Other			

NOTIFY HEALTH DEPARTMENT AT LEAST EIGHT HOURS BEFORE TANK IS TO BE INSPECTED.

Final Inspection 23 July 1965 Approved (✓) Disapproved ( )

Remarks Last 10' 12" Deep Well not Down.

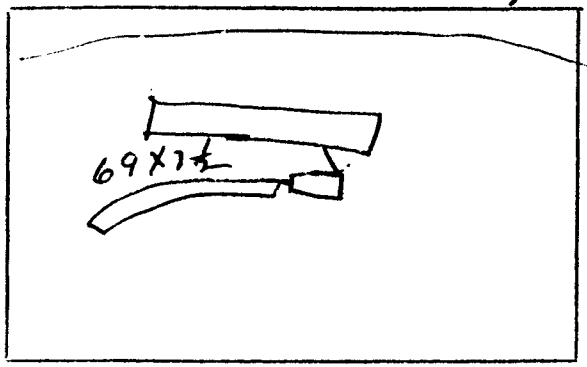

Sketch of Installation

Roy Sergeant

Sanitarian