IREDELL COUNTY HEALTH DEPARTMENT

4626016464

STATESVILLE 704-878-5305 MOORESVILLE 704-664-5281

IMPROVEMENT PERMIT / CERTIFICATE OF COMPLETION / OPERATION PERMIT / EXISTING SYSTEM INSPECTION

PROPERTY DESCRIPTION NO. 17740 DATE Feb 4, '94 TAX MAP NO. 2E1A 68 Watershed: ☑ Yes ☐ No

OWNER OR CONTRACTOR J. Michael Leatherwood PHONE: Business _____ Home _____

ADDRESS 222 Freyed St, Eden, NC

LOCATION 1100 TR 1177 to end TL Baker Loop TR 1st Cattaraugus Loop 2nd on Right

SUBDIVISION Crescent LN BLOCK / SECTION 7 LOT 68 LOT AREA _____ SITE CLASS. _____ DESIGN FLOW _____ L.T.A.R. _____

Septic Tank: 1000 Gallons; STB 794 Bellinger Date 4-20-94
Pump Tank: _____ Gallons; PT _____ Date _____
Pump Make: _____ Model _____ Serial No. _____
Nitrification Field: No Fields 1 Square Feet _____ Linear Feet 70-80'
No Lines 2 Trench Width 24" Max Trench Bottom Depth 36" Gravel Depth NA

☑ New System ☐ Repair System Type: I, II, III, IV, V, VI
System Description: gravity PPBPS
Repair System Description: same
Maintenance Agreement Required: ☐ Yes ☑ No


☑ House/Mod. Home No. Bedrooms 3
☐ Mobile Home No. Bathrooms 2
☐ Business No. Employees _____
☐ Other _____
☐ Slab ☑ Crawl Space ☐ Basement w/plumbing ☐ Basement wo/plumbing

Water Supply: ☑ Individual ☐ Community ☐ Public


Comments: Addition of bedroom, bath & garage. New system to accomodate plumbing from addition.

Comments: 70' (2-35's) as much as could be installed.

INITIAL SITE SKETCH

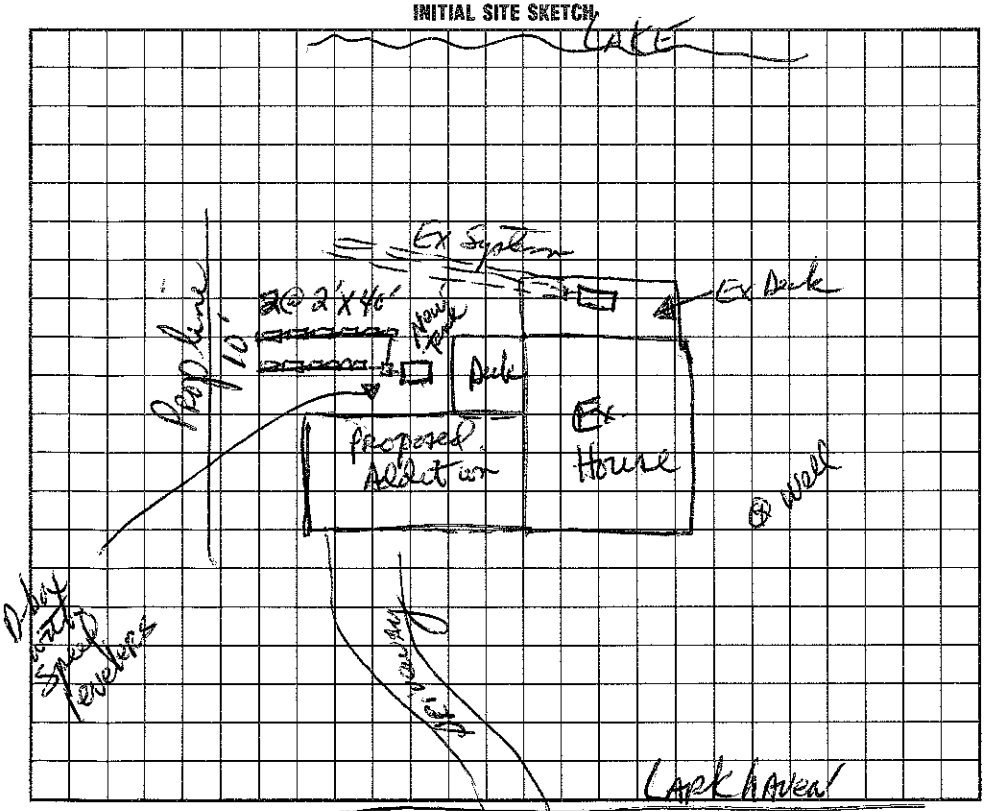

AS BUILT SKETCH

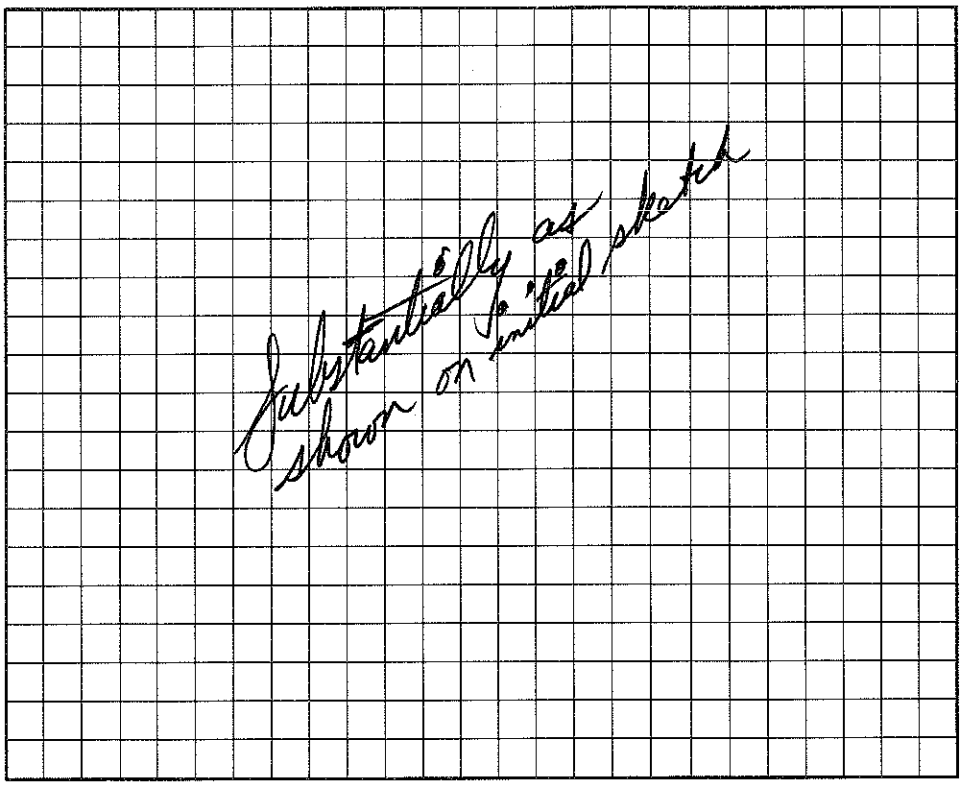

I understand that this permit can be suspended or revoked if any false information is supplied toward securing the permit/any unauthorized changes are made to the site/any unauthorized changes are made in the installation of the system. Improvement Permit is valid for 60 months from date of issuance.

Signed: J. Michael Leatherwood Installed by: John Howie

Improvement Permit by: Jaime R. Hinson, RS date 2/4/94 Certificate of Completion by: _____ date _____

Existing System Inspection by: _____ date _____ Operation Permit by: Jaime R. Hinson RS date 5/27/94

HEALTH DEPT. COPY: WHITE INSPECTION COPY (FINAL): GREEN OWNER COPY (FINAL): YELLOW INSPECTION COPY (INITIAL): PINK OWNER COPY (INITIAL): GOLD