IREDELL COUNTY HEALTH DEPARTMENT

STATESVILLE 704-878-5305 575.00 Paid MOORESVILLE 704-664-5281

IMPROVEMENT PERMIT / AUTHORIZATION TO CONSTRUCT / OPERATION PERMIT / EXISTING SYSTEM INSPECTION

PERMIT# 124495 PIN# 4626-03-8676 DATE 11/3/04

OWNER OR CONTRACTOR Adam Bloom PHONE: Business Home

ADDRESS 20000 1 Norman Circle Apt H Cornelius NC 28031

LOCATION BSR, TR McKendree, 4 tr end TL Kemp, on Rt #897

SUBDIVISION CLIT BLOCK / SECTION 8 LOT 197 LOT AREA 0.95AC SITE CLASS. PS DESIGN FLOW 480 L.T.A.R. 0.3

Septic Tank: 1000 Gallons; STB 312 Date 8/15/05
Pump Tank: 1000 Gallons; PT 282 Date 8/12/05
Pump Make: Little Giant Model 9EH Serial No.
Nitrification Field: No Fields 1 Square Feet 795 Linear Feet 265
No Lines 4 Trench Width 24" or 36" Max Trench Bottom Depth 36" Gravel Depth —

☒ New System ☐ Repair System Type: I, II, III, (IV) V, VI
System Description: LP Panel Block
Repair System Description: Limited LP Panel Block
Maintenance Agreement Required: ☒ Yes ☐ No Deeded P/W to 198


☒ House/Mod. Home No. Bedrooms 4
☐ Mobile Home No. Bathrooms
☐ Business No. Employees
☐ Other
☐ Slab ☒ Crawl Space ☐ Basement w/plumbing ☐ Basement wo/plumbing

Water Supply: ☒ Individual ☐ Public ☐ Community


Comments/Conditions: Old Well Must be Abandoned

Comments/Conditions: Supply Line Must be Constructed of Leakproof pipe equivalent to Water Main Standards in side of The 50' well Radius - No closer than 25'

INITIAL SITE SKETCH

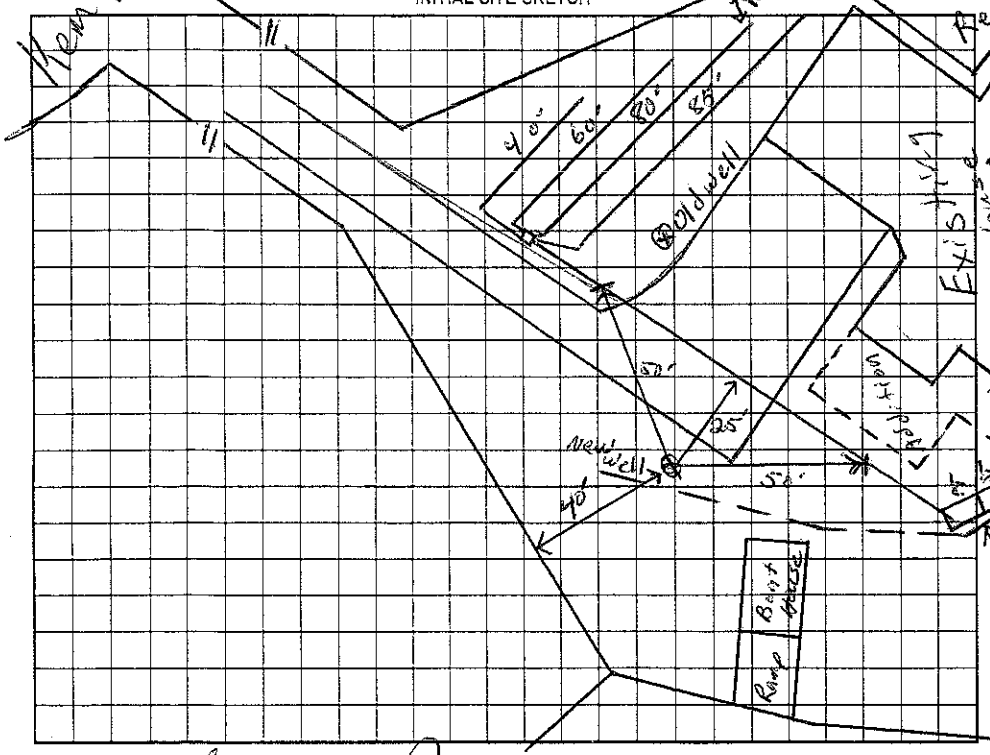

AS BUILT SKETCH

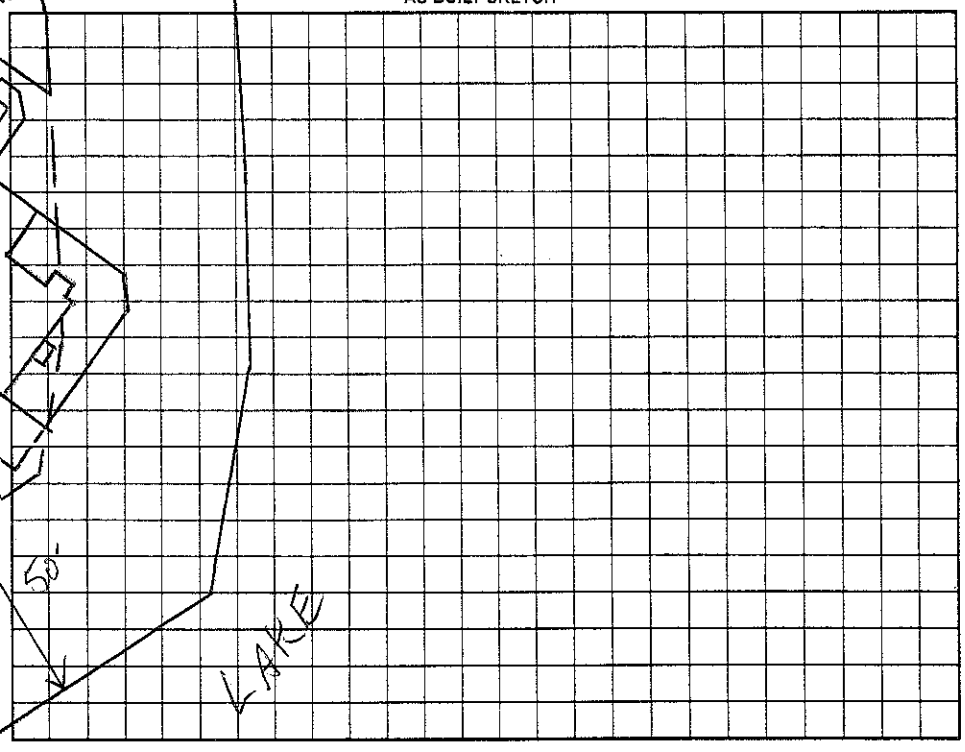

Permit can be suspended or revoked if any false information is supplied toward securing the permit/any unauthorized changes are made to the site/any unauthorized changes are made in the installation of the system. Improvement Permit with plat valid without expiration. Improvement Permit with site plan valid for sixty months. Authorization to Construct is valid for a period equal to that of Improvement Permit – not to exceed sixty months.

Signed: Adam Bloom date 12-1-04 Installed by: Abernathy

Improvement Permit by: RS date 11/3/04 Operation Permit by: RS date 10/10/05

Authorization to Construct by: RS date 11/3/04 Existing System Inspection by: date

HEALTH DEPT. COPY: WHITE OWNER COPY (FINAL): YELLOW OWNER COPY (INITIAL): PINK