IREDELL COUNTY HEALTH DEPARTMENT

STATESVILLE 704-878-5305 MOORESVILLE 704-664-5281

IMPROVEMENT PERMIT / CERTIFICATE OF COMPLETION / OPERATION PERMIT / EXISTING SYSTEM INSPECTION

PROPERTY DESCRIPTION NO. 17772 DATE Feb. 9, 1994 TAX MAP NO. 2 F3B11 Watershed: ☑ Yes ☐ No

OWNER OR CONTRACTOR Randy Baker PHONE: Business 329-2846 Home 4626-04-1967 L.N.

ADDRESS Rt 9, Box 736F Mooresville

LOCATION 1200 TR 1115 on left across from Hagers Creek Boat Access

SUBDIVISION Pine Knoll Pointe BLOCK / SECTION ____ LOT 11 LOT AREA ~197'X323' SITE CLASS. PS DESIGN FLOW 360gpd L.T.A.R. .2

Septic Tank: 1000 Gallons; STB 794 Bellinger Date 6-1-94

Pump Tank: ____ Gallons; PT ____ Date ____

Pump Make: ____ Model ____ Serial No. ____

Nitrification Field: No Fields 1 Square Feet 1800 Linear Feet 600

No Lines 5 Trench Width 36" Max Trench Bottom Depth 36" Gravel Depth 12"

☑ New System ☐ Repair System Type: I, II, III, IV, V, VI

System Description: gravity conventional

Repair System Description: pumped/grav conv.

Maintenance Agreement Required: ☐ Yes ☑ No

☑ House/Mod. Home No. Bedrooms 3

☐ Mobile Home No. Bathrooms 2½

☐ Business No. Employees ____

☐ Other


☐ Slab ☑ Crawl Space ☐ Basement w/plumbing ☐ Basement wo/plumbing

Water Supply: ☑ Individual ☐ Community ☐ Public


Comments: Follow contour. Exit plumbing near/at existing grade.

Comments:

INITIAL SITE SKETCH

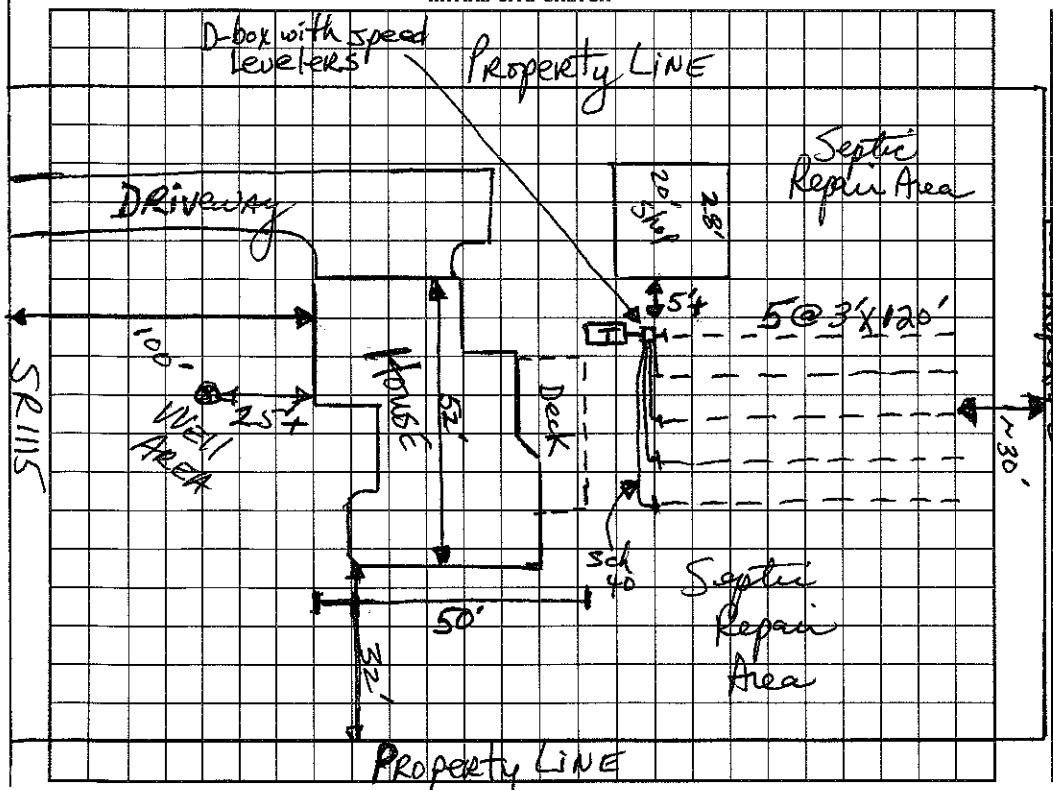

AS BUILT SKETCH

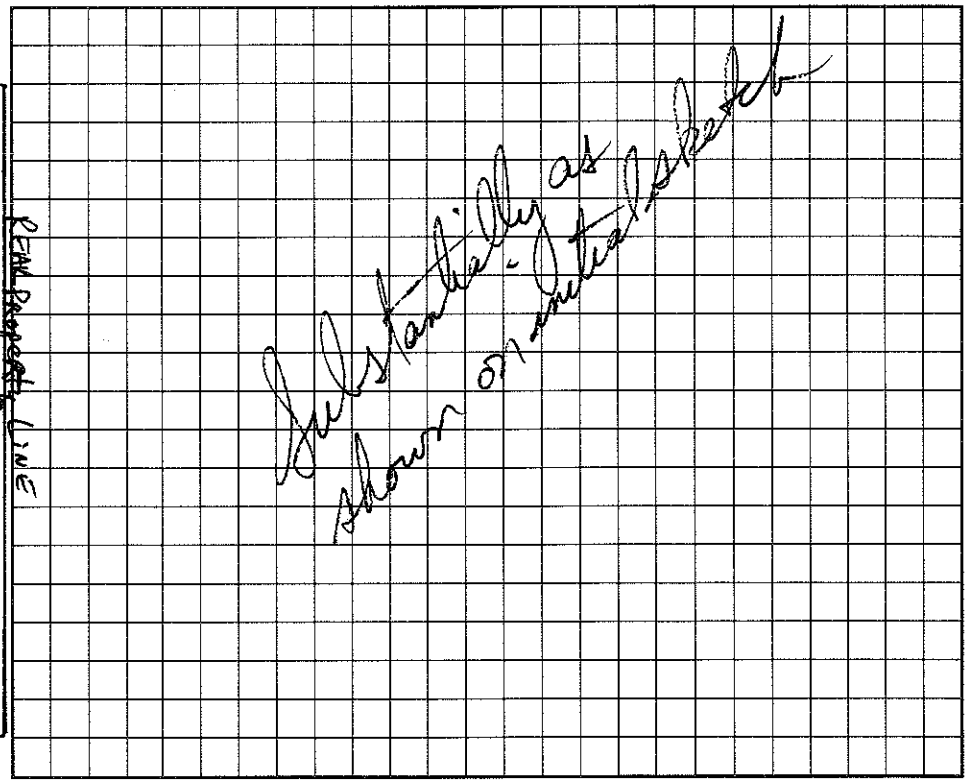

I understand that this permit can be suspended or revoked if any false information is supplied toward securing the permit/any unauthorized changes are made to the site/any unauthorized changes are made in the installation of the system. Improvement Permit is valid for 60 months from date of issuance.

Signed: [signature] [signature]

Improvement Permit by: [signature] date 2/9/94

Existing System Inspection by: ____ date ____

Installed by: [signature]

Certificate of Completion by: [signature] date 9/7/94

Operation Permit by: ____ date ____

HEALTH DEPT. COPY: WHITE INSPECTION COPY (FINAL): GREEN OWNER COPY (FINAL): YELLOW INSPECTION COPY (INITIAL): PINK OWNER COPY (INITIAL): GOLD