IREDELL COUNTY HEALTH DEPARTMENT

STATESVILLE 704-878-5305 550.00 Paid 350 MOORESVILLE 704-664-5281

IMPROVEMENT PERMIT / AUTHORIZATION TO CONSTRUCT / OPERATION PERMIT / EXISTING SYSTEM INSPECTION

PERMIT# 133101 PIN# 4626042128 DATE 10/10/06

OWNER OR APPLICANT EFC Associates Inc PHONE: Business Home

ADDRESS 101 Castles Gate Drive Mooresville 28117

LOCATION Brawley Sch Rd, TR McKendree, Go to End & T Lon Last Kemp Rd, 1st on Rt

SUBDIVISION Pine Knoll BLOCK / SECTION LOT 6 LOT AREA .75 Ac SITE CLASS. P5 DESIGN FLOW 480 gpd T.A.R. .30 gpd/ft²

Septic Tank: 1000 Gallons: STB 312 Date 12-19-06

Pump Tank: 1000 Gallons: PT 7993 Date 11-11-06

Pump Make: Gentes Model PG5T Serial No.

Nitrification Field: No Fields 1 Square Feet 810 ft* Linear Feet 270'

No Lines 3 @ 90' Trench Width 36" Max Trench Bottom Depth 36"

☒ New System ☐ Repair ☐ Expansion System Type: I II III IV V VI

System Description: LP - PBBPS

Repair System Description: SAME

Maintenance Agreement Required: ☒ Yes ☐ No

☒ House/Mod. Home No. Bedrooms 4

☐ Mobile Home No. Persons

☐ Business No. Employees

☐ Other

Water Supply: ☒ Individual ☐ Public ☐ Community

Gravel Depth N/A ☐ Gravity ☒ Pressure ☐ Slab ☐ Crawl Space ☒ Basement w/plumbing ☐ Basement wo/plumbing

Comments:/Conditions:

All parts of system AT LEAST 15' From Basement foundation & 10' From any property line


- Drain lines = 9' on center

Comments:/Conditions:

*USE Ductile IRON (or equivalent pipe) under driveway for supply line - OR - run it AT LEAST 30 inches deep, plus 5 Ft on Both sides of drive

(1" = 50')

INITIAL SITE SKETCH

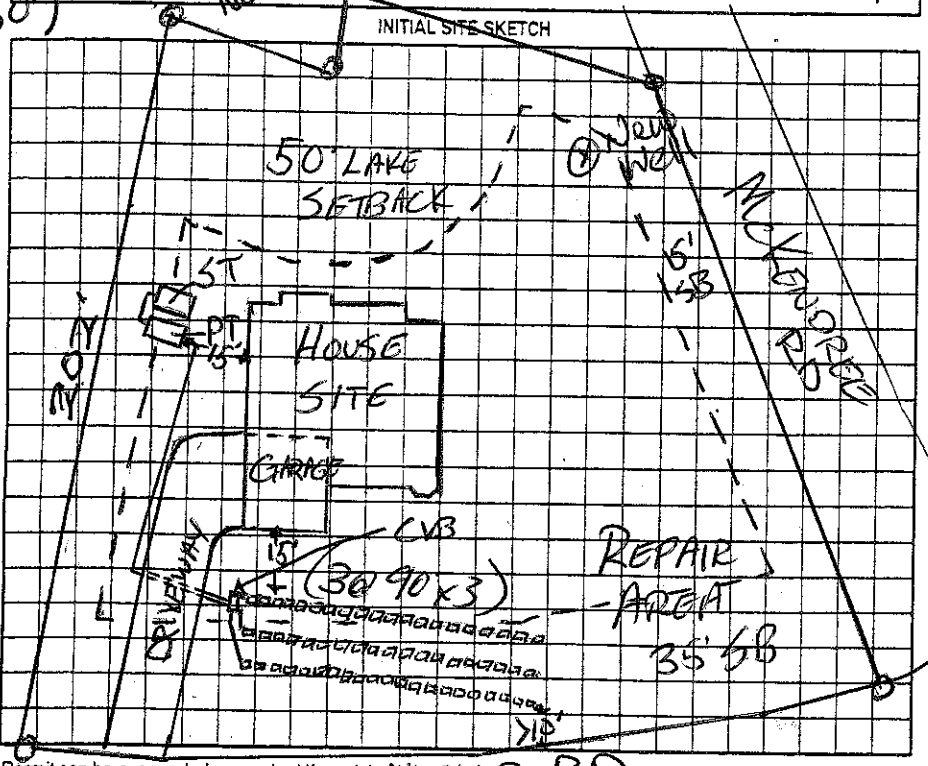

AS BUILT SKETCH

Permit can be suspended or revoked if any false information is supplied toward securing the permit/any unauthorized changes are made to the site/any unauthorized changes are made in the installation of the system. Improvement Permit with plat valid without expiration. ☐ Improvement Permit with site plan valid for sixty months. ☒ Authorization to Construct is valid for a period equal to that of Improvement Permit – not to exceed sixty months.

Signed: [signature] date 10/12/06 Installed by: Richard Abernethy

Improvement Permit by: Joseph E Allgh date 10-11-06 Operation Permit by: Joseph E Allgh date 4-25-07

Authorization to Construct by: Joseph E Allgh date 10-11-06 Existing System Inspection by: date

HEALTH DEPT. COPY: WHITE OWNER COPY (FINAL): YELLOW OWNER COPY (INITIAL): PINK