10:45

IREDELL COUNTY HEALTH DEPARTMENT

STATESVILLE 704-878-5305 MOORESVILLE 704-664-5281

IMPROVEMENT PERMIT / AUTHORIZATION TO CONSTRUCT / OPERATION PERMIT / EXISTING SYSTEM INSPECTION

PERMIT# 079241 PIN# 4626042442 DATE 2/24/99

OWNER OR CONTRACTOR BETTY ANN SUESS PHONE: Business Home 799-2469

ADDRESS 646 FRANKLIN GROVE DR. MOORESVILLE NC 28115

LOCATION BRAWLEY SCHOOL - TR MCKENDREE - AT CORNER OF LAST KEMP

SUBDIVISION PINE KNOLL PT BLOCK / SECTION LOT 15 LOT AREA .91AC SITE CLASS. PS DESIGN FLOW 360 L.T.A.R. .3

Septic Tank: 1000 Gallons; STB 1012 Date 8/29/99
Pump Tank: Gallons; PT Date
Pump Make: Model Serial No.
Nitrification Field: No Fields 1 Square Feet 400 Linear Feet 200
No Lines 4@50' Trench Width 24" Max Trench Bottom Depth 36" Gravel Depth N/A

☒ New System ☐ Repair System Type: I, II, III, IV, V, VI
System Description: GRAVITY FANG
Repair System Description: PUMP CHAMBERS
Maintenance Agreement Required: ☐ Yes ☒ No OR HOS

☒ House/Mod. Home No. Bedrooms 3
☐ Mobile Home No. Bathrooms 2
☐ Business No. Employees
☐ Other


☐ Slab ☒ Crawl Space ☐ Basement w/plumbing ☐ Basement wo/plumbing

Water Supply: ☐ Individual ☐ Public ☐ Community

Comments:/Conditions: KEEP HOUSE FAR ENOUGH AWAY FROM PROPERTY LINE TO ACCOMODATE FOR 4-50' LINES - ~~FROM~~ LINES TO BE 5' OFF OF HOUSE AND 10' OFF OF PROPERTY LINES

Comments:/Conditions: WAS TOLD IN FIELD HOUSE IS GOING TO BE CRAWL

NEW WELL LOCATION INITIAL SITE SKETCH 248'

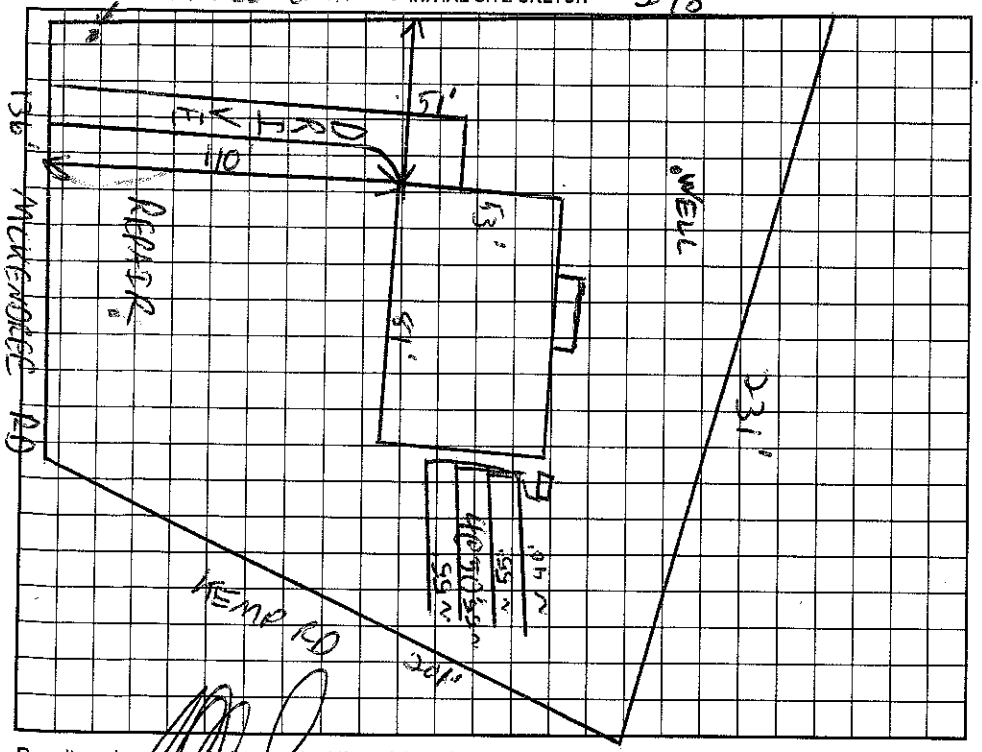

AS BUILT SKETCH

Installed as Drawn Except used Drop Boxes instead of D-Box 1st line shorter than others.

MD

Permit can be suspended or revoked if any false information is supplied toward securing the permit/any unauthorized changes are made to the site/any unauthorized changes are made in the installation of the system. Improvement Permit with plat valid without expiration. Improvement Permit with site plan valid for sixty months. Authorization to Construct is valid for a period equal to that of Improvement Permit – not to exceed sixty months.

Signed: date 2/25/99 Installed by: A-1 Backhoe

Improvement Permit by: date 2/24/99 Operation Permit by: date 11/12/99

Authorization to Construct by: date 2/24/99 Existing System Inspection by: date

HEALTH DEPT. COPY: WHITE OWNER COPY (FINAL): YELLOW OWNER COPY (INITIAL): PINK