IREDELL COUNTY HEALTH DEPARTMENT

STATESVILLE 704-878-5305 MOORESVILLE 704-664-5281

IMPROVEMENT PERMIT / ~~CERTIFICATE OF COMPLETION~~ / OPERATION PERMIT / EXISTING SYSTEM INSPECTION

→ Authorization to Construct

PROPERTY DESCRIPTION NO. 22810 DATE 11/30/95 TAX MAP NO. 2F-3-B-14 Watershed: ☑ Yes ☐ No

OWNER OR CONTRACTOR Sam Peter PHONE: Business 881-3768 Home 4626-04-2536

ADDRESS 19716 Smith Cir Apt 25 Cornelius NC 28031

LOCATION 1100, tr McKendric, on Lt near end

SUBDIVISION Pine Knoll Point BLOCK / SECTION ____ LOT 14 LOT AREA 270'x248'x132' SITE CLASS. PS DESIGN FLOW 360 gpd L.T.A.R. .3 gpd/ft²

Septic Tank: 1000 Gallons; STB 794 Date 5/1/96

Pump Tank: ____ Gallons; PT ____ Date ____

Pump Make: ____ Model ____ Serial No. ____

Nitrification Field: No Fields 1 Square Feet 1800 Linear Feet # 300

No Lines 3 Trench Width 36" Max Trench Bottom Depth 36" Gravel Depth @ N/A

☑ New System ☐ Repair System Type: I, II, (III), IV, V, VI

System Description: Gravity Chambered

Repair System Description: Gravity Chambered

Maintenance Agreement Required: ☐ Yes ☑ No

☑ House/Mod. Home No. Bedrooms 3

☐ Mobile Home No. Bathrooms 2

☐ Business No. Employees ____

☐ Other ____


☐ Slab ☐ Crawl Space ☑ Basement w/plumbing ☐ Basement wo/plumbing

Water Supply: ☑ Individual ☐ Community ☐ Public


Comments: # 300 ft of Infiltrator. Grinder Pump in Basement is required for plumbing in basement. Well at least 100' from any part of system and repair

Comments: Install Lot as shown on Imp Permit

INITIAL SITE SKETCH

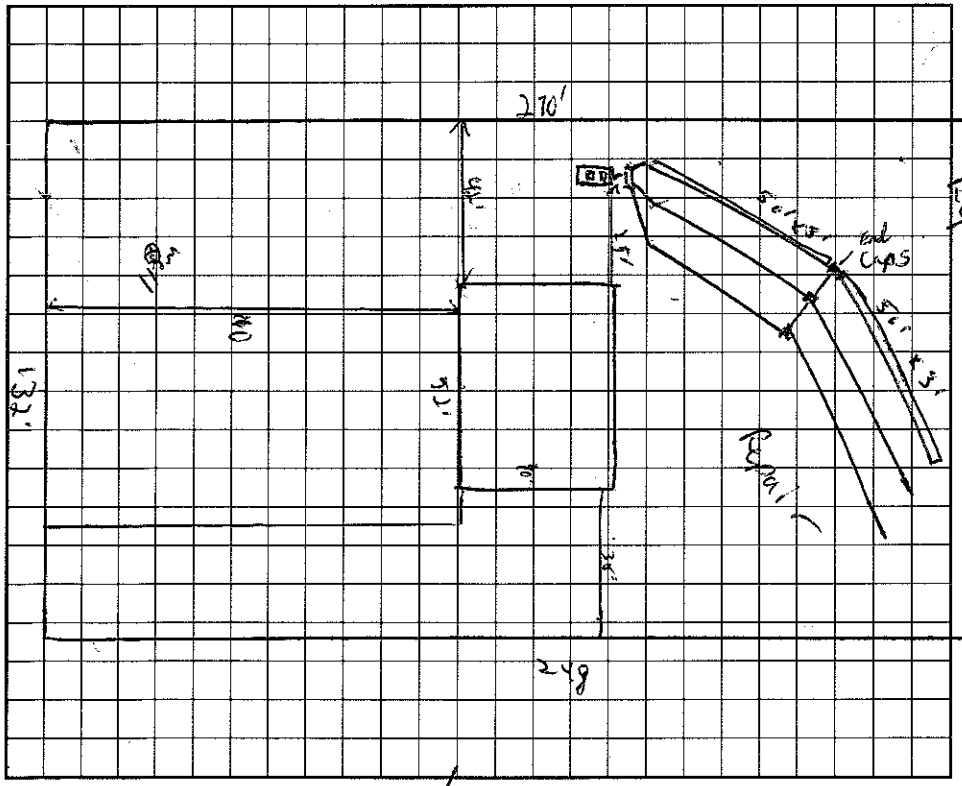

AS BUILT SKETCH

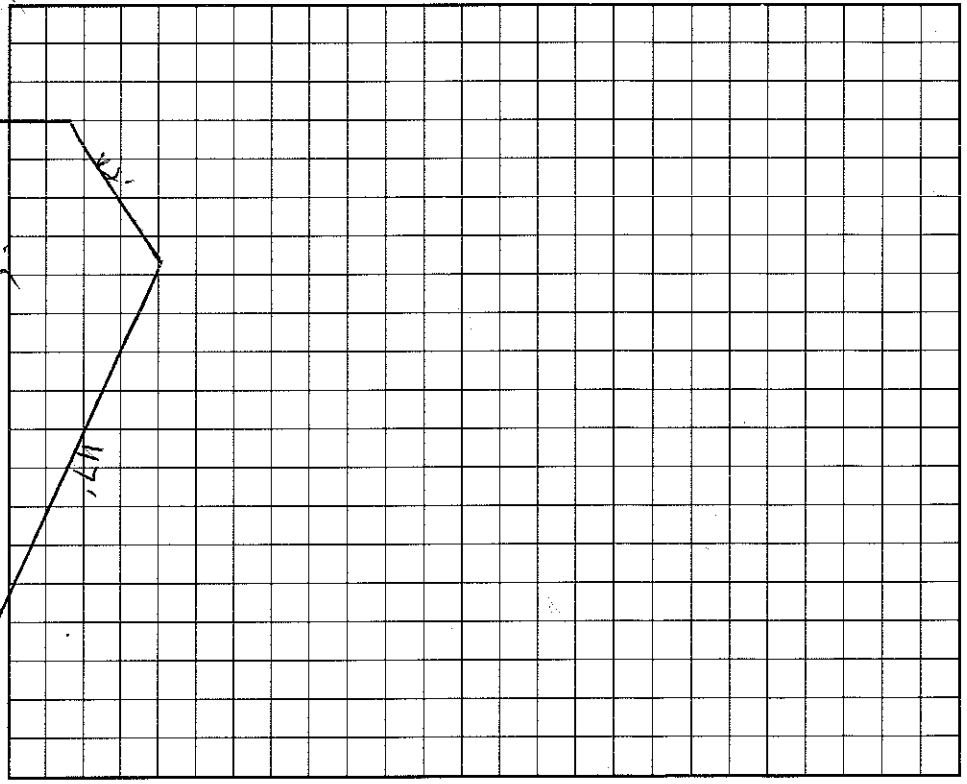

I understand that this permit can be suspended or revoked if any false information is supplied toward securing the permit/any unauthorized changes are made to the site/any unauthorized changes are made in the installation of the system.

Signed: X

Improvement Permit by: Wesley Sparks RS date 11/30/95

~~Existing System Inspection by:~~ Construct! Wesley Sparks RS date 11/30/95

Installed by: Larry Bean

Certificate of Completion by: ____ date ____

Operation Permit by: Wesley Sparks RS. date 5/30/96

HEALTH DEPT. COPY: WHITE INSPECTION COPY (FINAL): GREEN OWNER COPY (FINAL): YELLOW INSPECTION COPY (INITIAL): PINK OWNER COPY (INITIAL): GOLD