(11:30)

IREDELL COUNTY HEALTH DEPARTMENT

STATESVILLE 704-878-5305 MOORESVILLE 704-664-5281

IMPROVEMENT PERMIT / CERTIFICATE OF COMPLETION / OPERATION PERMIT / EXISTING SYSTEM INSPECTION

PROPERTY DESCRIPTION NO. 18052 DATE March 28, '94 TAX MAP NO. 2F3B12 Watershed: ☑ Yes ☐ No

OWNER OR CONTRACTOR Gerald Reby PHONE: Business 4626-04-2804 Home

ADDRESS c/o [redacted] Susie Bonge Rt 8, Box 409, Mooresville

LOCATION 400' TR 1115 on left across from Hagar's Creek Boat Access

SUBDIVISION Pine Knoll Pointe BLOCK / SECTION LOT 12 LOT AREA 1 acre SITE CLASS. C5 DESIGN FLOW 360 gpd L.T.A.R. .02

Septic Tank: 1000 Gallons; STB 794 Date 2/25/18

Pump Tank: Gallons; PT Date

Pump Make: Model Serial No. 450 LF

Nitrification Field: No Lines 4 Rows 1 Square Feet 1800 Linear Feet ~~450~~

No Lines 4 Rows Trench Width 36" Max Trench Bottom Depth 30" Gravel Depth 12"

☑ New System ☐ Repair System Type: I, II, III, IV, V, VI

System Description: gravity conventional

Repair System Description: pumped conv. or PRBPS

Maintenance Agreement Required: ☐ Yes ☑ No

☑ House/Mod. Home No. Bedrooms 3

☐ Mobile Home No. Bathrooms 2

☐ Business No. Employees

☐ Other


☐ Slab ☑ Crawl Space ☐ Basement w/plumbing ☐ Basement wo/plumbing

Water Supply: ☑ Individual ☐ Community ☐ Public

Comments: Exit plumbing from house at grinding grade level. Follow contour with nitrification laterals.

Comments: 10/29/97 - May use CH PLASTIC - 450 LIN. FEET

INITIAL SITE SKETCH

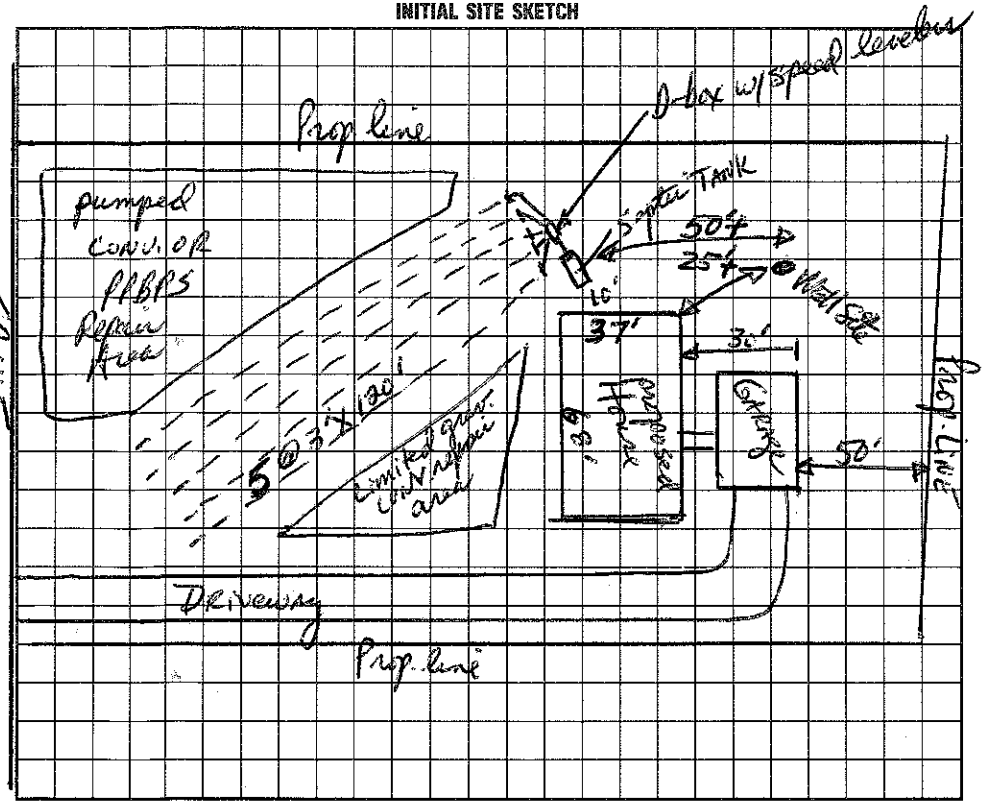

AS BUILT SKETCH

I understand that this permit can be suspended or revoked if any false information is supplied toward securing the permit/any unauthorized changes are made to the site/any unauthorized changes are made in the installation of the system. Improvement Permit is valid for 60 months from date of issuance.

Signed: [redacted]

Improvement Permit by: Jack R. Hanson, RS date 3/28/94

Existing System Inspection by: date

Installed by: ATLANTIC GRADING

Certificate of Completion by: C. Ray Hanson RS date 6/11/98

Operation Permit by: date

HEALTH DEPT. COPY: WHITE INSPECTION COPY (FINAL): GREEN OWNER COPY (FINAL): YELLOW INSPECTION COPY (INITIAL): PINK OWNER COPY (INITIAL): GOLD