IREDELL COUNTY HEALTH DEPARTMENT

STATESVILLE 704-878-5305 MOORESVILLE 704-664-5281

IMPROVEMENT PERMIT / CERTIFICATE OF COMPLETION / OPERATION PERMIT / EXISTING SYSTEM INSPECTION

PROPERTY DESCRIPTION NO. 1511 DATE 12/10/95 TAX MAP NO. 2F3B22 Watershed: [X] Yes [ ] No

OWNER OR CONTRACTOR George Eckert PHONE: Business _____ Home 4626-04-5658

ADDRESS Kemp Rd. Mocksville, NC 28115

LOCATION Kemp Rd. around curve at Pine Knoll Ct. to ~ 6 lot on (L)

SUBDIVISION Pine Knoll Pt BLOCK / SECTION A LOT 22 LOT AREA _____ SITE CLASS. _____ DESIGN FLOW _____ L.T.A.R. _____

Septic Tank: 1000 Gallons; STB 794 Date 9/6/95

Pump Tank: _____ Gallons; PT _____ Date _____

Pump Make: _____ Model _____ Serial No. _____

Nitrification Field: No Fields 1 Square Feet 1200 Linear Feet 400

No Lines 4 Trench Width 36" Max Trench Bottom Depth 36" Gravel Depth 12"

[X] New System [ ] Repair System Type: I, (II), III, IV, V, VI

System Description: CONV - 81ST Bot

Repair System Description: _____

Maintenance Agreement Required: [ ] Yes [X] No

[X] House/Mod. Home No. Bedrooms 3

[ ] Mobile Home No. Bathrooms 2

[ ] Business No. Employees _____

[ ] Other _____

[ ] Slab [X] Crawl Space [ ] Basement w/plumbing [ ] Basement wo/plumbing


Water Supply:
[X] Individual
[ ] Community
[ ] Public

Comments:

Comments:

INITIAL SITE SKETCH

AS BUILT SKETCH

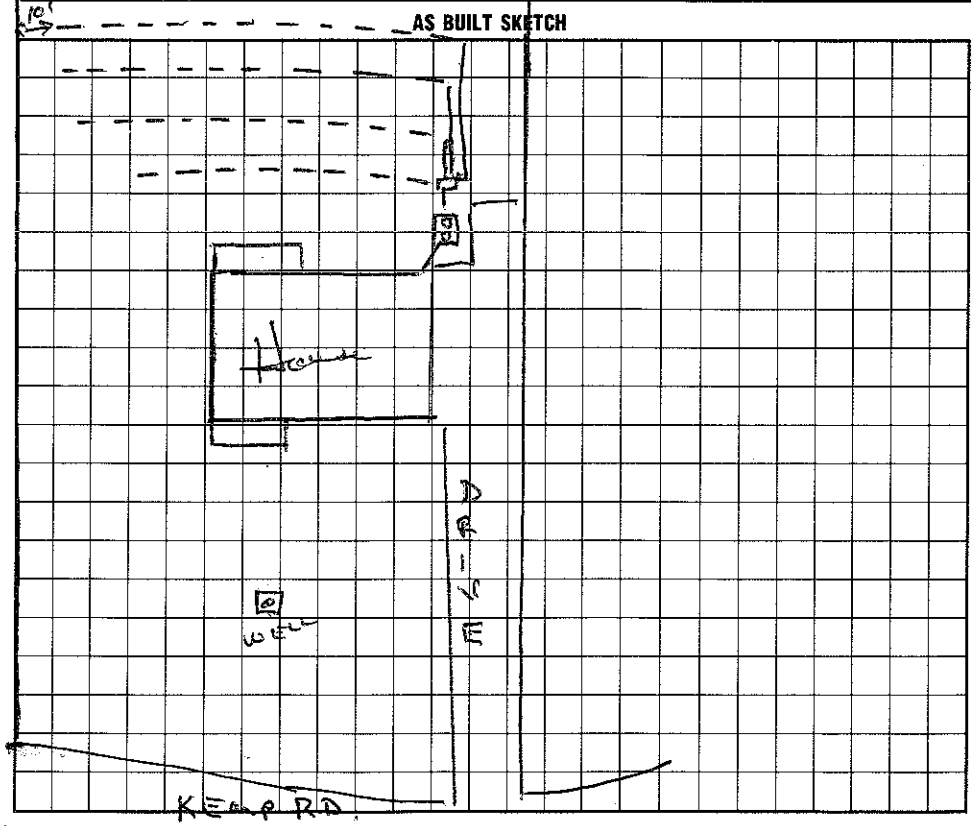

I understand that this permit can be suspended or revoked if any false information is supplied toward securing the permit/any unauthorized changes are made to the site/any unauthorized changes are made in the installation of the system.

Signed: _____

Improvement Permit by: _____ date _____

Existing System Inspection by: _____ date _____

Installed by: Dennis Gulcher

Certificate of Completion by: Wesley Sparks R.S. date 12/6/95

Operation Permit by: Wesley Sparks R.S. date 12/11/95

HEALTH DEPT. COPY: WHITE INSPECTION COPY (FINAL): GREEN OWNER COPY (FINAL): YELLOW INSPECTION COPY (INITIAL): PINK OWNER COPY (INITIAL): GOLD