IREDELL COUNTY HEALTH DEPARTMENT

STATESVILLE 704-878-5305 MOORESVILLE 704-664-5281

IMPROVEMENT PERMIT / AUTHORIZATION TO CONSTRUCT / OPERATION PERMIT / EXISTING SYSTEM INSPECTION

PERMIT# 075297 PIN# 4626 04 9901 DATE 5/14/98

OWNER OR CONTRACTOR TIM CARYL PHONE: Business _____ Home 947-0770

ADDRESS 849 KEMP RD - MOORESVILLE NC 28115

LOCATION BRAWLEY SCHOOL - TR MCKENDREE - TL 2ND KEMP - TR - ON RT LT LAKESHORE & #849

SUBDIVISION CLST BLOCK / SECTION 8 LOT 188 LOT AREA 1.034c SITE CLASS. PS DESIGN FLOW 360 GPD L.T.A.R. .83

Septic Tank: 1000 Gallons; STB 312 Date 5/28/98

Pump Tank: _____ Gallons; PT _____ Date _____

Pump Make: _____ Model _____ Serial No. _____

Nitrification Field: No Fields 1 Square Feet 300 Linear Feet 100

No Lines 3@33 Trench Width 36" Max Trench Bottom Depth 36" Gravel Depth N/A

☑ New System ☐ Repair System Type: I, (II) III, IV, V, VI

System Description: GRAVITY CONVENTIONAL

Repair System Description: _____

Maintenance Agreement Required: ☐ Yes ☑ No

☑ House/Mod. Home No. Bedrooms 3

☐ Mobile Home No. Bathrooms 2

☐ Business No. Employees _____

☐ Other _____


☐ Slab ☐ Crawl Space ☑ Basement w/plumbing ☐ Basement wo/plumbing

Water Supply: ☑ Individual ☐ Public ☐ Community

Comments:/Conditions:

Comments:/Conditions:

INITIAL SITE SKETCH

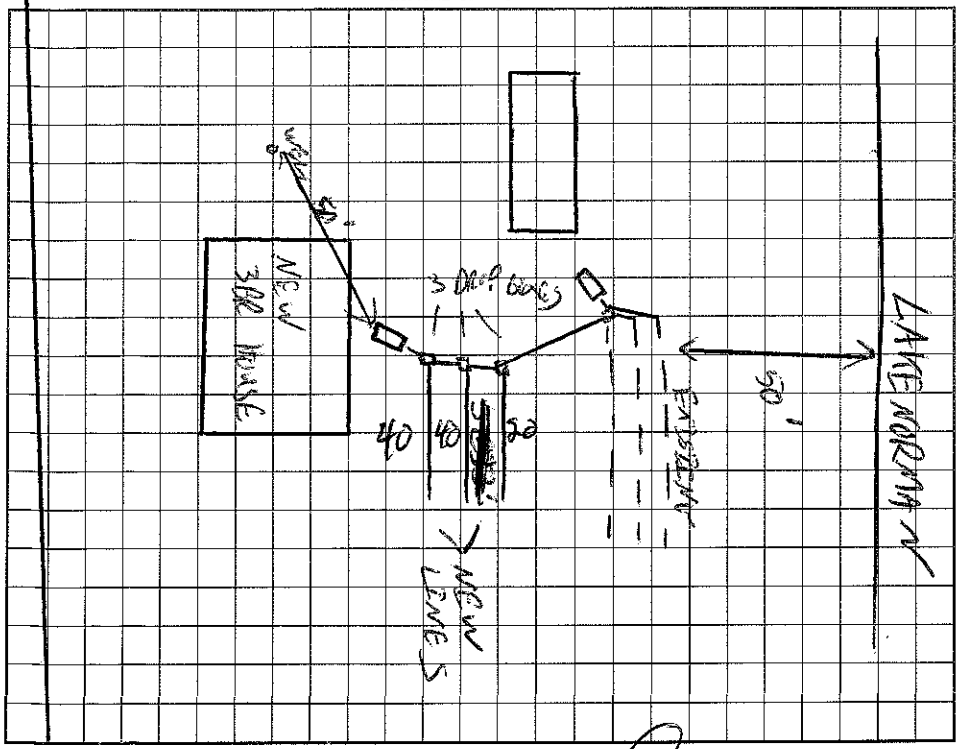

AS BUILT SKETCH

I understand that this permit can be suspended or revoked if any false information is supplied toward securing the permit/any unauthorized changes are made to the site/any unauthorized changes are made in the installation of the system. Improvement Permit with plat valid without expiration. Improvement Permit with site plan valid for sixty months. Authorization to Construct is valid for a period equal to that of Improvement Permit – not to exceed sixty months.

Signed: _____ date 5/14/98

Improvement Permit by: _____ RS date 5/14/98

Authorization to Construct by: _____ RS date 5/14/98

Installed by: MARK INGLE

Operation Permit by: _____ RS date 7/20/99

Existing System Inspection by: _____ date _____

HEALTH DEPT. COPY: WHITE INSPECTION COPY (FINAL): GREEN OWNER COPY (FINAL): YELLOW INSPECTION COPY (INITIAL): PINK OWNER COPY (INITIAL): GOLD