IREDELL COUNTY HEALTH DEPARTMENT

Statesville Office (704) 878-5305 Mooresville Office (704) 660-3625 AP PERMIT # 207242

IMPROVEMENT PERMIT / AUTHORIZATION TO CONSTRUCT / OPERATION PERMIT / EXISTING SYSTEM

PIN # 4626-05-0284

APPLICANT: MIKE ATHANAS APPLICANT ADDRESS: 561 ENNIS RD. WEDDINGTON NC

SITE ADDRESS: 761 McKENDREE RD. PHONE: 704-576-3887 ALT. PHONE:

SITE DIRECTIONS: BSR, TR McKENDREE, ON L

SUBDIVISION: PINE KNOLL POINTE SECTION: LOT # 9 LOT AREA: .85 AC DESIGN FLOW: 360 L.T.A.R.: .25

Septic Tank 1000 (gal) STB 794 Date 6-24-15

Pump Tank (gal) PT Date

Pump Make Model Serial #

Nitrification Fields 1 # Lines 3 Linear Ft: 360'

Trench Width 36" Max. Trench Bottom Depth 36" min Gravel Depth

☒ New System ☐ Repair ☐ Expansion System Type: I II (III) IV V VI

System Description: 25% REDUCTION

Repair System Description: SAME

Maintenance Agreement Required: ☐ YES ☒ NO

☒ GRAVITY ☐ PRESSURE

☒ Residence ☐ Business ☐ Other ☒ Slab ☐ Basement w/plumbing

No. Bedrooms 3 No. Persons No. Employees ☐ Crawl Space

Water Supply: ☒ Private ☐ Public ☐ Community

☐ Basement w/o plumbing

Comments / Conditions: Install Trenches @ 36" Deep

INITIAL SITE SKETCH

SEE PLAN FROM MICHAEL ATHANAS & ASSOCIATES

AS BUILT SKETCH

29 IN TOP LINE
30 IN MIDDLE
29 IN BOTTOM

Permit can be suspended or revoked if any false information is supplied toward securing the permit / any unauthorized changes are made to the site / any unauthorized changes are made in the installation of the system. **CONTACT A LOCATOR SERVICE PRIOR TO ANY EXCAVATION**

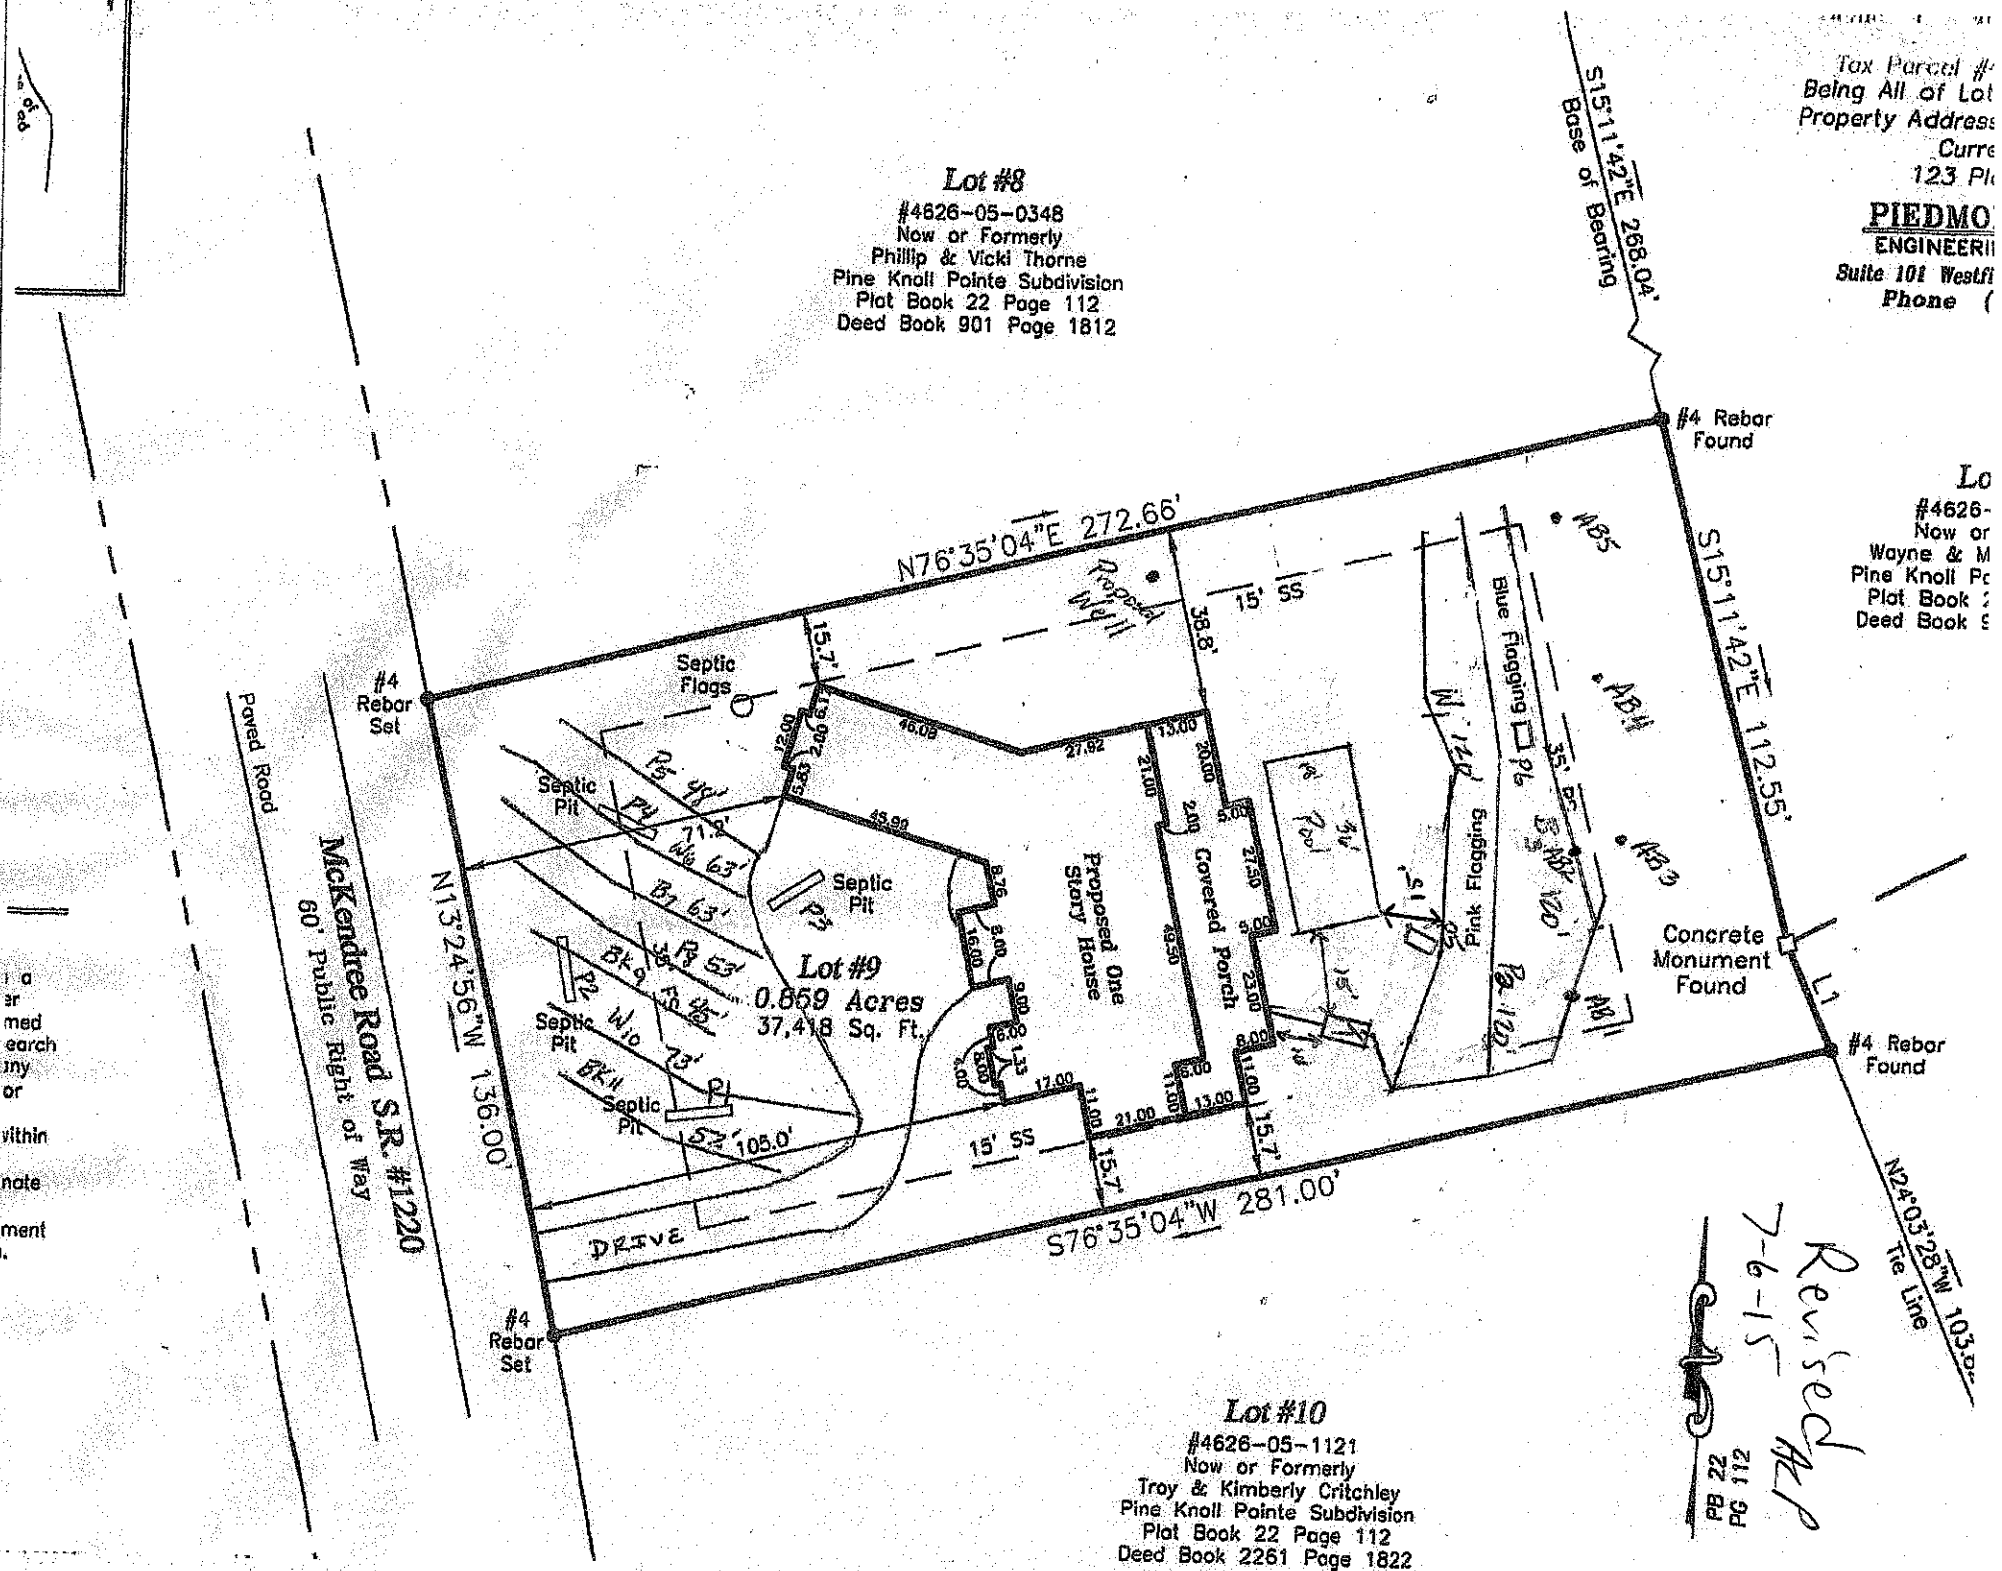
☐ **IMPROVEMENT PERMIT** *with plat valid without expiration.* ☐ **IMPROVEMENT PERMIT** *with site plan valid for 60 mos.* ☐ **AUTHORIZATION TO CONSTRUCT** *valid for period equal to IMPROVEMENT PERMIT--not to exceed 60 mo.*

Owner / Applicant Signature: Richard Allen Date: 2/13/15 Installed by: ABERNATHY

IMPROVEMENT PERMIT by: APPROVED FEB 05 2015 OPERATION PERMIT by: APPROVED AUG 07 2015

AUTHORIZATION TO CONSTRUCT by: APPROVED FEB 06 2015 Existing System Inspected by: Date:

Health Dept. Copy - WHITE Applicant (Final Approval) - YELLOW Applicant (Conditional Approval) - PINK


Lot #8
#4626-05-0348
Now or Formerly
Phillip & Vicki Thorne
Pine Knoll Pointe Subdivision
Plat Book 22 Page 112
Deed Book 901 Page 1812
S15°11'42"E 268.04'
Base of Bearing
#4 Rebar Found
N76°35'04"E 272.66'
15' SS
38.8'
15.7'
Septic Flags
#4 Rebar Set
Paved Road
McKendree Road S.R. #1220
60' Public Right of Way
Septic Pit
Septic Pit
Septic Pit
Septic Pit
Lot #9
0.859 Acres
37,418 Sq. Ft.
Proposed One Story House
Covered Porch
Blue Flagging
Pink Flagging
Concrete Monument Found
#4 Rebar Found
S15°11'42"E 112.55'
N13°24'56"W 136.00'
S76°35'04"W 281.00'
15' SS
DRIVE
#4 Rebar Set
N24°03'28"W 103.2
Tie Line
Lot #10
#4626-05-1121
Now or Formerly
Troy & Kimberly Critchley
Pine Knoll Pointe Subdivision
Plat Book 22 Page 112
Deed Book 2261 Page 1822
PB 22 PG 112
Revised Map
7-6-15