IREDELL COUNTY HEALTH DEPARTMENT

STATESVILLE 704-878-5305 MOORESVILLE 704-664-5281

IMPROVEMENT PERMIT / CERTIFICATE OF COMPLETION / OPERATION PERMIT / EXISTING SYSTEM INSPECTION

PROPERTY DESCRIPTION NO. 18051 DATE March 28, 94 TAX MAP NO. 2F3B7 Watershed: ☑ Yes ☐ No

OWNER OR CONTRACTOR William Mueller PHONE: Business 4626-05-0535 Home L.N.

ADDRESS % Susie Bonge RFD, Box 409, Mooresville

LOCATION I-40W TR 1109 TR 1100 TR 1115 on left before Hager's Cr. Boat Access

SUBDIVISION Pine Knoll Pointe BLOCK / SECTION ____ LOT 7 LOT AREA 1.96±ac SITE CLASS. B pr. 1556 DESIGN FLOW 360gpd L.T.A.R. .03

Septic Tank: 1000 Gallons; STB 794 Bellinger Date 4-27-94

Pump Tank: ____ Gallons; PT ____ Date ____

Pump Make: ____ Model ____ Serial No. ____

Nitrification Field: No Fields 1 Square Feet 1200 Linear Feet 400

No Lines 3+3 Trench Width 36" Max Trench Bottom Depth 36" per 24" Gravel Depth 12"

☑ New System ☐ Repair System Type: I, II, III, IV, V, VI

System Description: gravity conventional

Repair System Description: grav. PPBPS

Maintenance Agreement Required: ☐ Yes ☑ No

☑ House/Mod. Home No. Bedrooms 3

☐ Mobile Home No. Bathrooms 2

☐ Business No. Employees ____

☐ Other ____


☐ Slab ☑ Crawl Space ☐ Basement w/plumbing ☐ Basement wo/plumbing

Water Supply: ☑ Individual ☐ Community ☐ Public


Comments:

Comments: Changes in system design approved prior to installation.

INITIAL SITE SKETCH

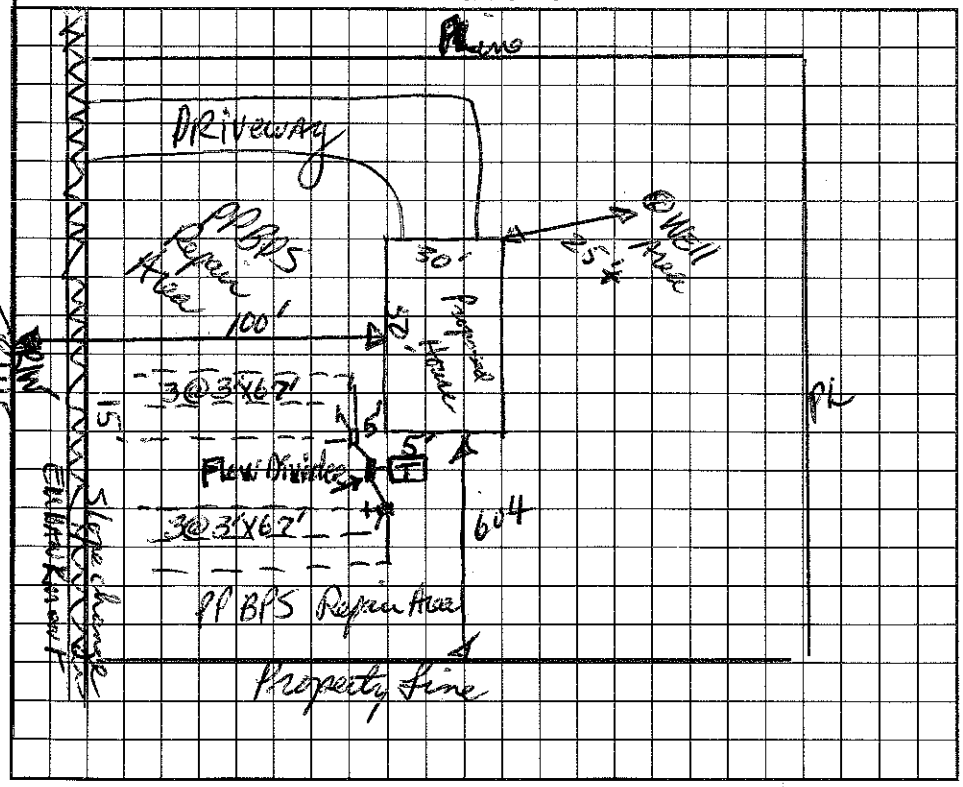

AS BUILT SKETCH

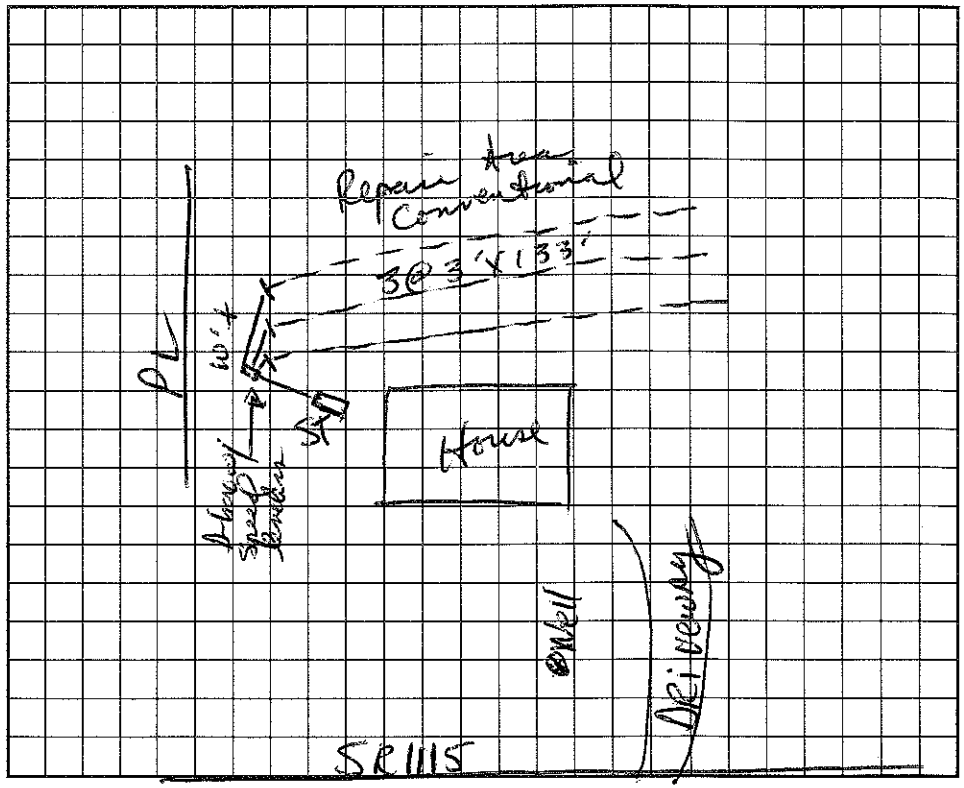

I understand that this permit can be suspended or revoked if any false information is supplied toward securing the permit/any unauthorized changes are made to the site/any unauthorized changes are made in the installation of the system. Improvement Permit is valid for 60 months from date of issuance.

Signed: ____

Improvement Permit by: Darrell Hinson IRS date 3/28/94

Existing System Inspection by: ____ date ____

Installed by: Larry Beane

Certificate of Completion by: D Hinson IRS date 11/14/94

Operation Permit by: ____ date ____

HEALTH DEPT. COPY: WHITE INSPECTION COPY (FINAL): GREEN OWNER COPY (FINAL): YELLOW INSPECTION COPY (INITIAL): PINK OWNER COPY (INITIAL): GOLD