IREDELL COUNTY HEALTH DEPARTMENT

STATESVILLE 704-878-5305 MOORESVILLE 704-664-5281

IMPROVEMENT PERMIT / CERTIFICATE OF COMPLETION / OPERATION PERMIT / EXISTING SYSTEM INSPECTION

PROPERTY DESCRIPTION NO. 19358 DATE Dec 1, '94 TAX MAP NO. 2F3810 Watershed: ☑ Yes ☐ No

OWNER OR CONTRACTOR Leon Bouwens PHONE: Business 4626-05-1121 Home WS IV

ADDRESS 1003 Stutts Rd. Mooresville

LOCATION 1100 TR 1115 (McKendree) on left near Hagers Creek Boat Access

SUBDIVISION Pine Knoll Pointe BLOCK / SECTION LOT 10 LOT AREA 136' X 280'± SITE CLASS. PS DESIGN FLOW 360 gpd L.T.A.R. .25

Septic Tank: 1000 Gallons; STB 794 Date 10/6/95

Pump Tank: Gallons; PT Date

Pump Make: Model Serial No.

Nitrification Field: No Fields 1 Square Feet 1440 Linear Feet 480

No Lines 5 Trench Width 36" Max Trench Bottom Depth 30-36" Gravel Depth 12"

☑ New System ☐ Repair System Type: I, II, III, IV, V, VI

System Description: gravity conventional

Repair System Description: Same / PPBPS

Maintenance Agreement Required: ☐ Yes ☑ No

☑ House/Mod. Home No. Bedrooms 3

☐ Mobile Home No. Bathrooms 3

☐ Business No. Employees

☐ Other

☐ Slab ☑ Crawl Space ☐ Basement w/plumbing ☐ Basement wo/plumbing


Water Supply: ☑ Individual ☐ Community ☐ Public

Comments: Follow contour w/ laterals. Exit plumbing at existing grade where shown.


12-12-95 OK to install 360 gpd INFILTRATOR ORK

Comments:

INITIAL SITE SKETCH

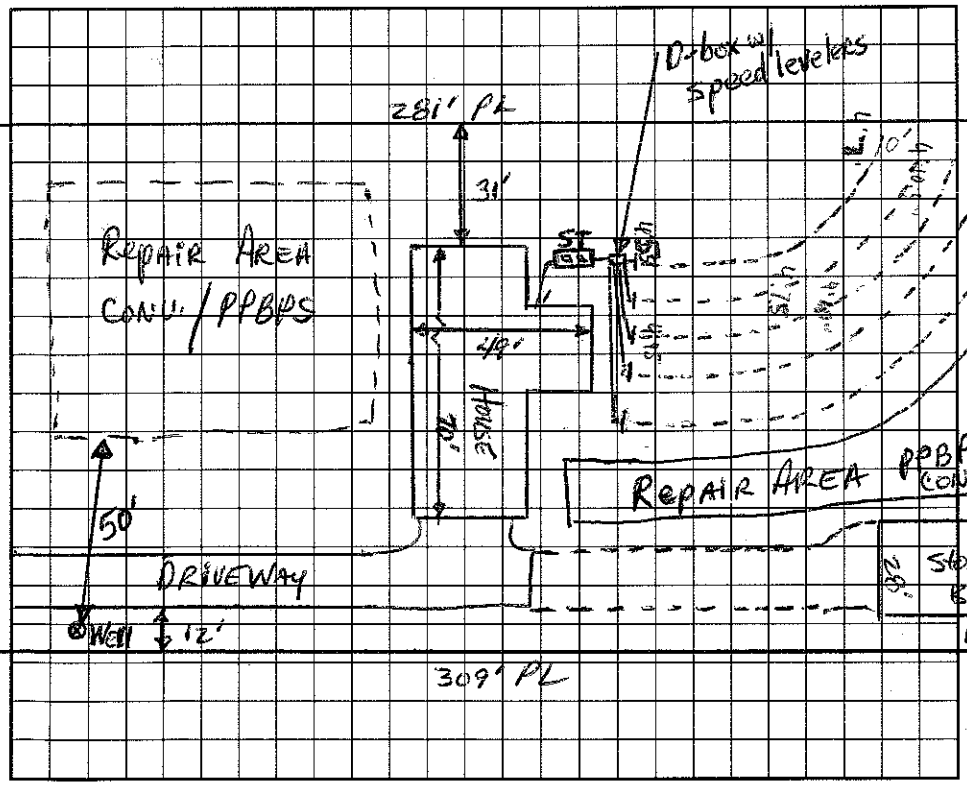

AS BUILT SKETCH

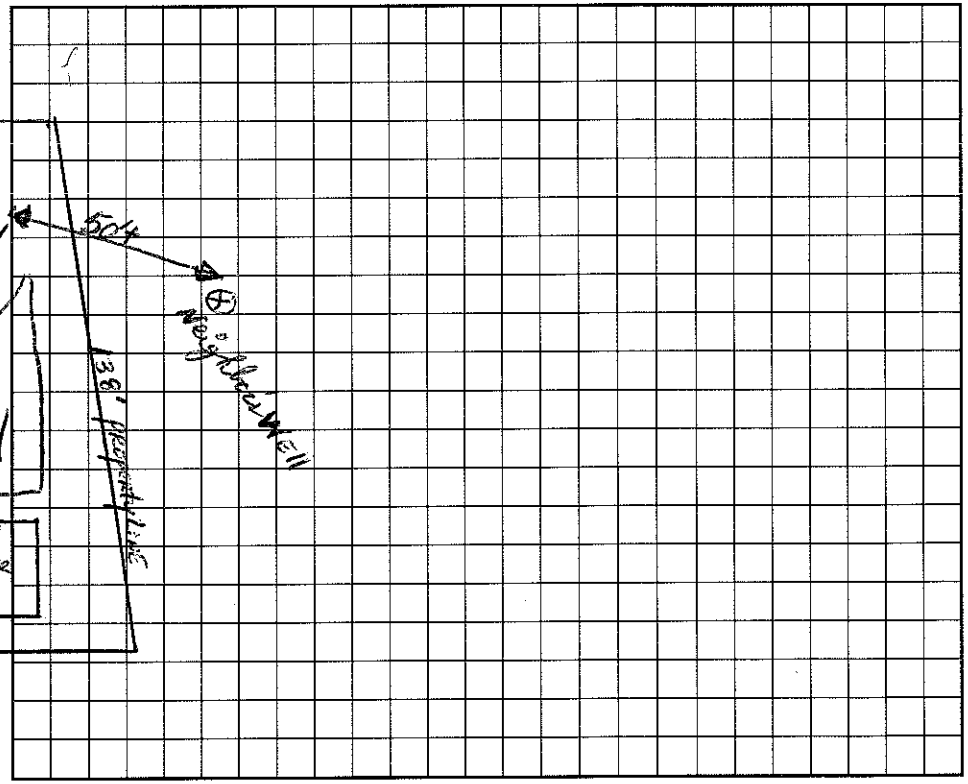

I understand that this permit can be suspended or revoked if any false information is supplied toward securing the permit/any unauthorized changes are made to the site/any unauthorized changes are made in the installation of the system. Improvement Permit is valid for 60 months from date of issuance.

Signed: Leon C. Bouwens

Improvement Permit by: David R. Hanson, RS date 12/1/94

Existing System Inspection by: date

Installed by: Leon Bouwens

Certificate of Completion by: Wesley Sparks RS. date 12/18/95

Operation Permit by: Wesley Sparks RS. date 12/18/95

HEALTH DEPT. COPY: WHITE INSPECTION COPY (FINAL): GREEN OWNER COPY (FINAL): YELLOW INSPECTION COPY (INITIAL): PINK OWNER COPY (INITIAL): GOLD