IREDELL COUNTY HEALTH DEPARTMENT

STATESVILLE 704-878-5305 MOORESVILLE 704-664-5281

IMPROVEMENT PERMIT / CERTIFICATE OF COMPLETION / OPERATION PERMIT / EXISTING SYSTEM INSPECTION

PROPERTY DESCRIPTION NO. 17397 DATE Jan. 17, '95 TAX MAP NO. 2P3B30 Watershed: ☑ Yes ☐ No

OWNER OR CONTRACTOR James E. Callard PHONE: Business 4626-05-2780 Home LN Mosic

ADDRESS 106 Dick East, Mooresville

LOCATION 400 The McKendree to end bear left onto Kemp 1/2 mile on left

SUBDIVISION Pine Knoll Forest BLOCK / SECTION ____ LOT 30 LOT AREA 1.11Ac SITE CLASS. PS on 1958 DESIGN FLOW 360gpd L.T.A.R. .3

Septic Tank: 1000 Gallons; STB 794 Date 4/9/95

Pump Tank: ____ Gallons; PT ____ Date ____

Pump Make: ____ Model ____ Serial No. ____

Nitrification Field: No Fields ____ Square Feet ____ Linear Feet 400

No Lines 5-6 Trench Width 36" Max Trench Bottom Depth 30" Gravel Depth 12"

☑ New System ☐ Repair System Type: I, II, III, IV, V, VI

System Description: gravity conventional

Repair System Description: gravity/LPP PPBPS

Maintenance Agreement Required: ☐ Yes ☑ No

☑ House/Mod. Home No. Bedrooms 3

☐ Mobile Home No. Bathrooms 2½

☐ Business No. Employees ____

☐ Other ____


☐ Slab ☑ Crawl Space ☐ Basement w/plumbing ☐ Basement wo/plumbing

Water Supply: ☑ Individual ☐ Community ☐ Public


Comments: If six laterals are needed, set flow divider to 2 subfields zone 0 by pass field with 200' on each subfield. Follow contour w/ laterals.

Comments:

INITIAL SITE SKETCH 1" = 50'

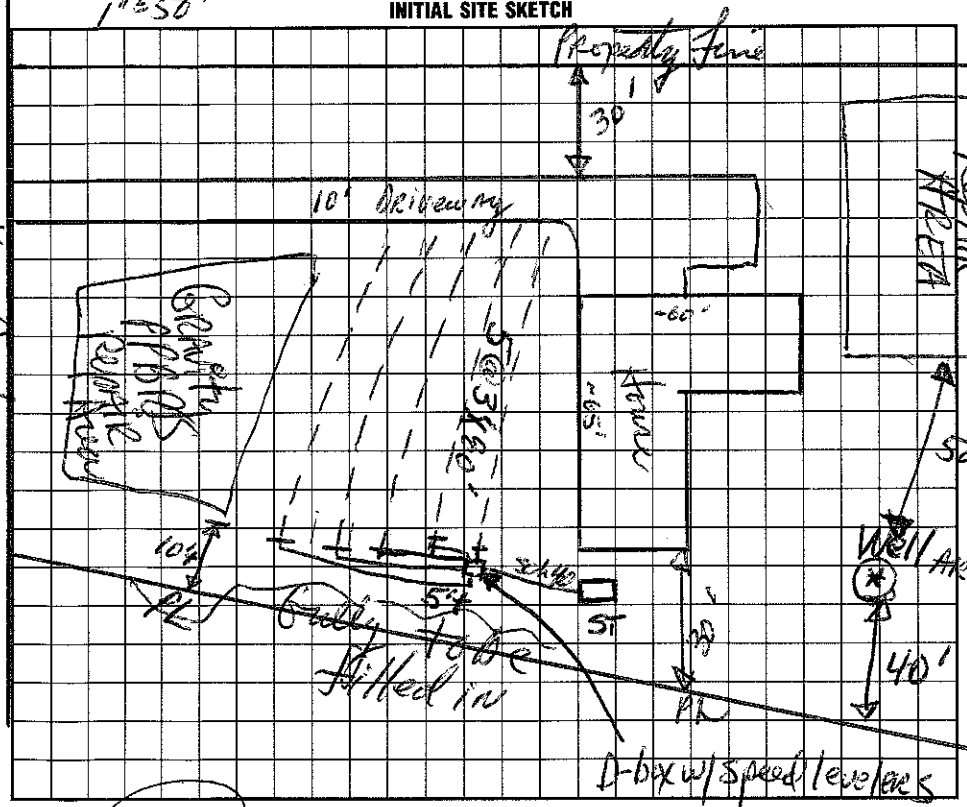

AS BUILT SKETCH

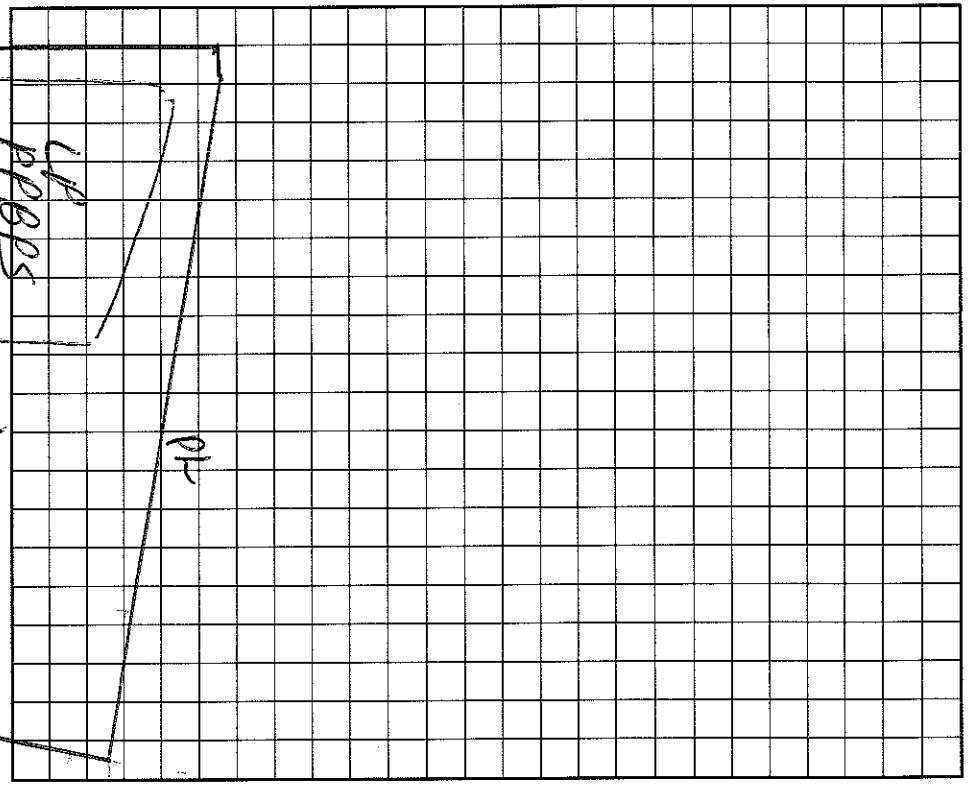

I understand that this permit can be suspended or revoked if any false information is supplied toward securing the permit/any unauthorized changes are made to the site/any unauthorized changes are made in the installation of the system. Improvement Permit is valid for 60 months from date of issuance.

Signed: ____ 4-21-95

Improvement Permit by: ____ date 1-17-95

Existing System Inspection by: ____ date ____

Installed by: Benton Landscaping

Certificate of Completion by: Wesley Sparks R.S. date 12/1/95

Operation Permit by: Wesley Sparks R.S. date 12/1/95

HEALTH DEPT. COPY: WHITE INSPECTION COPY (FINAL): GREEN OWNER COPY (FINAL): YELLOW INSPECTION COPY (INITIAL): PINK OWNER COPY (INITIAL): GOLD