IREDELL COUNTY HEALTH DEPARTMENT

STATESVILLE 704-878-5305 MOORESVILLE 704-664-5281

IMPROVEMENT PERMIT / CERTIFICATE OF COMPLETION / OPERATION PERMIT / EXISTING SYSTEM INSPECTION

PROPERTY DESCRIPTION NO. 20943 DATE May 2, 195 TAX MAP NO. 2F3 ? Watershed: ☑ Yes ☐ No

OWNER OR CONTRACTOR Wayne Earth PHONE: Business 4626-05-34460 Home

ADDRESS 175 E. Wilkerson Blvd Mooresville

LOCATION Brawley School Rd TR McCandless to end bear left ½ mile on left

SUBDIVISION Pine Russell Pointe BLOCK / SECTION LOT 28 LOT AREA 1.3 AC SITE CLASS. I Spr 1996 DESIGN FLOW 360 gpd L.T.A.R. .03

Septic Tank: 1000 Gallons; STB 794 Date 10/11/95

Pump Tank: Gallons; PT Date

Pump Make: Model Serial No.

Nitrification Field: No. Fields 1 Square Feet 900 Linear Feet 300

No. Lines 4 Trench Width 36" Max Trench Bottom Depth 36" Gravel Depth N/A

☑ New System ☐ Repair System Type: I, II, III, IV, V, VI

System Description: gravity w/fill material

Repair System Description: Conv. PPBPS

Maintenance Agreement Required: ☐ Yes ☑ No

☑ House/Mod. Home No. Bedrooms 3

☐ Mobile Home No. Bathrooms 3

☐ Business No. Employees

☐ Other

☐ Slab ☑ Crawl Space ☑ Basement w/plumbing ☐ Basement wo/plumbing

Water Supply: ☑ Individual ☐ Community ☐ Public


Comments: House Site can be moved further off street if conventional system is desired

Comments:

INITIAL SITE SKETCH

1" = 50'

AS BUILT SKETCH

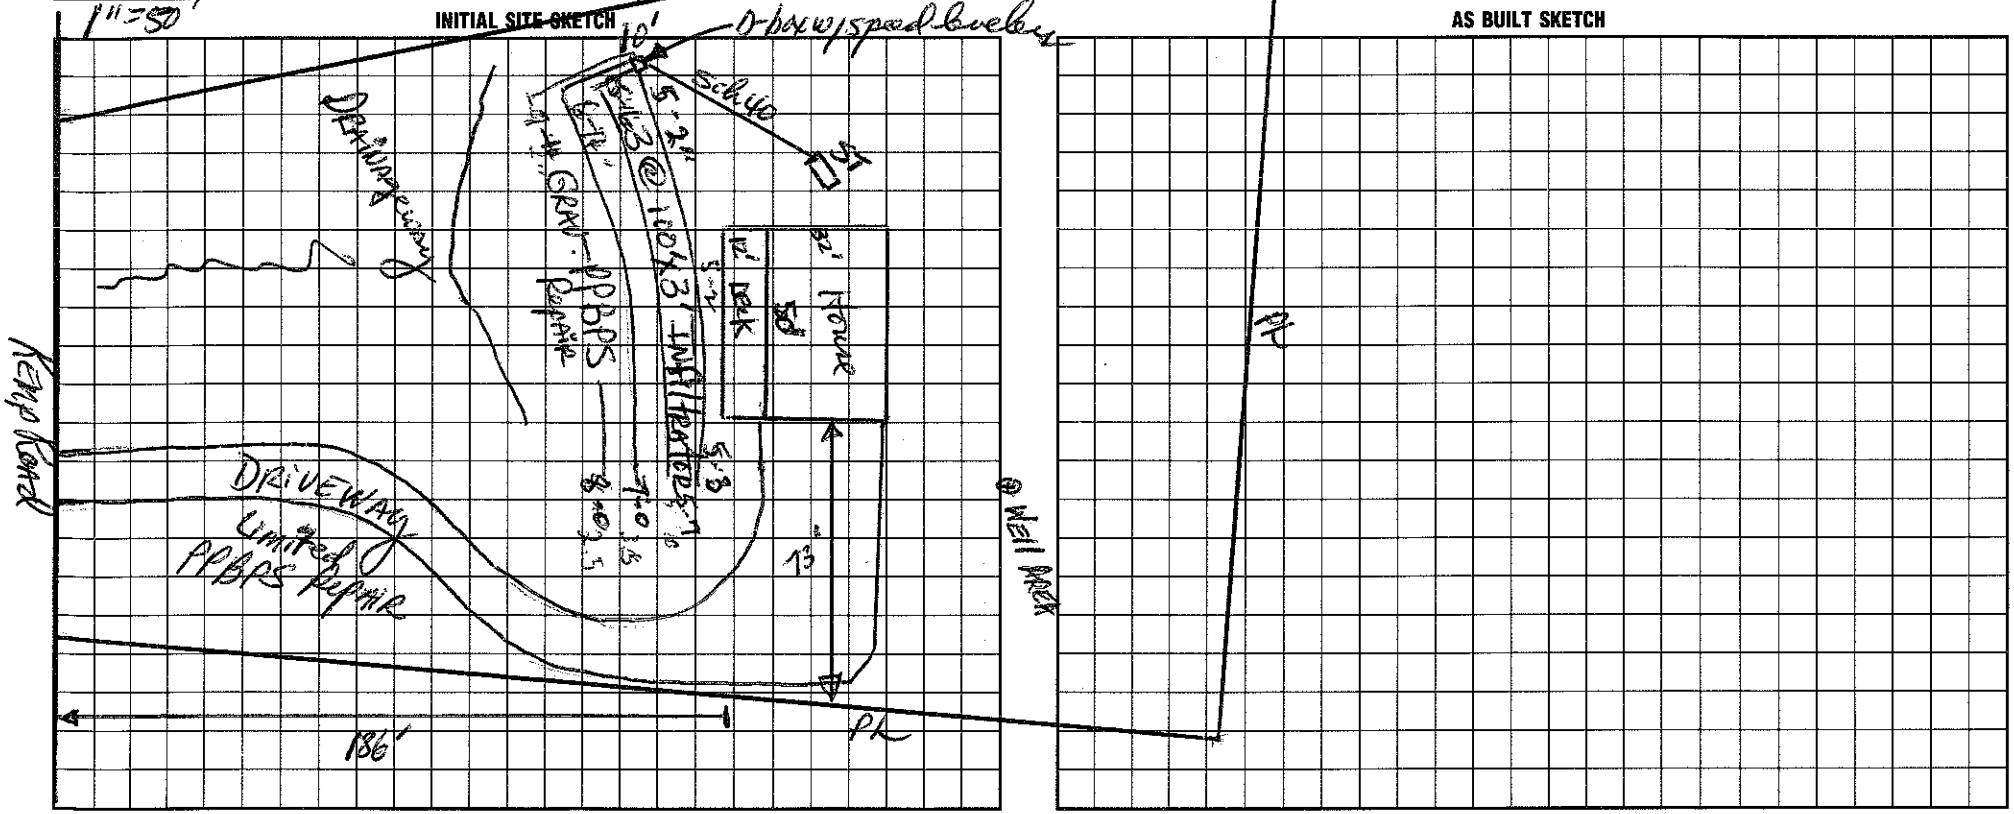

I understand that this permit can be suspended or revoked if any false information is supplied toward securing the permit/any unauthorized changes are made to the site/any unauthorized changes are made in the installation of the system. Improvement Permit is valid for 60 months from date of issuance.

Signed:

Improvement Permit by: date 5/2/95

Existing System Inspection by: date

Installed by: A Cornelius Grading

Certificate of Completion by: date

Operation Permit by: date 12/14/95

HEALTH DEPT. COPY: WHITE INSPECTION COPY (FINAL): GREEN OWNER COPY (FINAL): YELLOW INSPECTION COPY (INITIAL): PINK OWNER COPY (INITIAL): GOLD