IREDELL COUNTY HEALTH DEPARTMENT

STATESVILLE 704-878-5305 MOORESVILLE 704-664-5281

IMPROVEMENT PERMIT / CERTIFICATE OF COMPLETION / OPERATION PERMIT / EXISTING SYSTEM INSPECTION

PROPERTY DESCRIPTION NO. 1676 DATE Jan. 11, '94 TAX MAP NO. 2F3B29 Watershed: ☑ Yes ☐ No

OWNER OR CONTRACTOR Jay Fuchwaldt PHONE: Business 4626-05-3505 Home (704) 455-3400 L.N

ADDRESS PO Box 457, Harrisburg

LOCATION 1100 TR 1115 TL Kemp (2nd) TR - 2000' on Rt.

SUBDIVISION Pine Knoll Pointe BLOCK / SECTION ____ LOT 29 LOT AREA ~44,000 ft² SITE CLASS. RS DESIGN FLOW 360 gpd L.T.A.R. .3

Septic Tank: 1000 ✓ Gallons; STB F14 Date 5-6-94

Pump Tank: ____ Gallons; PT ____ Date ____

Pump Make: ____ Model ____ Serial No. ____

Nitrification Field: No Fields 1 Square Feet 1200 Linear Feet 400

No Lines 4 Trench Width 36" Max Trench Bottom Depth 24-30" Gravel Depth 12"

☑ New System ☐ Repair System Type: I, (II) III, IV, V, VI

System Description: gravity conventional

Repair System Description: same

Maintenance Agreement Required: ☐ Yes ☑ No

☑ House/Mod. Home No. Bedrooms 3

☐ Mobile Home No. Bathrooms 2½

☐ Business No. Employees ____

☐ Other ____


☐ Slab ☑ Crawl Space ☐ Basement w/plumbing ☐ Basement wo/plumbing

Water Supply: ☑ Individual ☐ Community ☐ Public


Comments: follow contour with nitrification laterals.

Comments: 24" TRENCH BOTTOM CONSISTENTLY

INITIAL SITE SKETCH

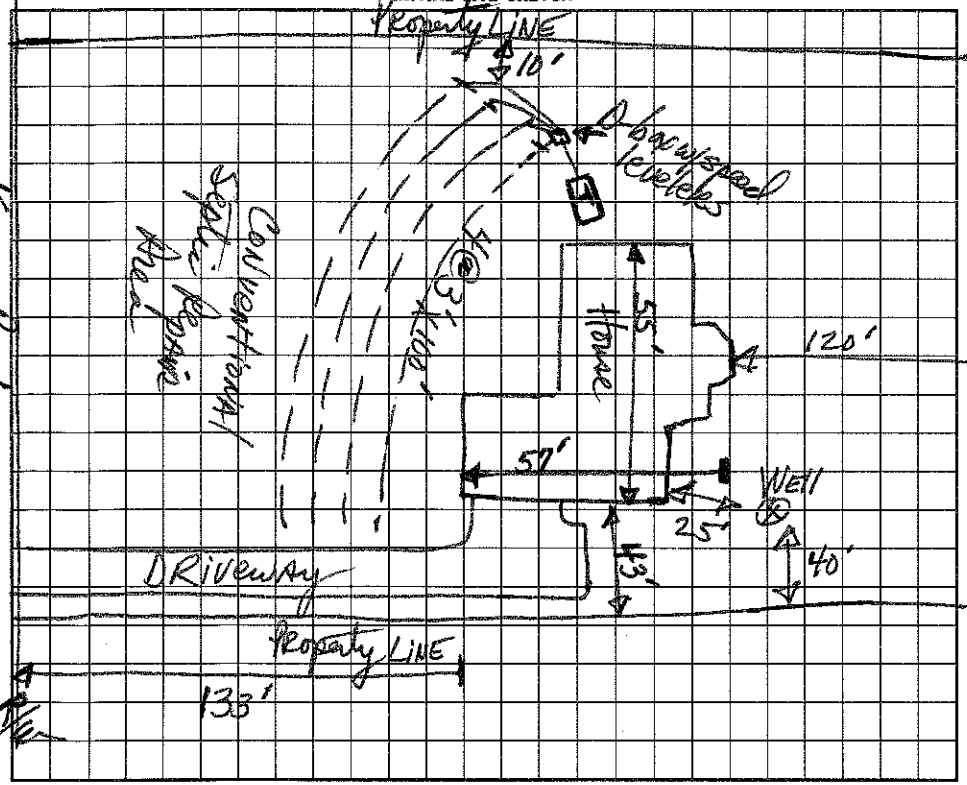

AS BUILT SKETCH

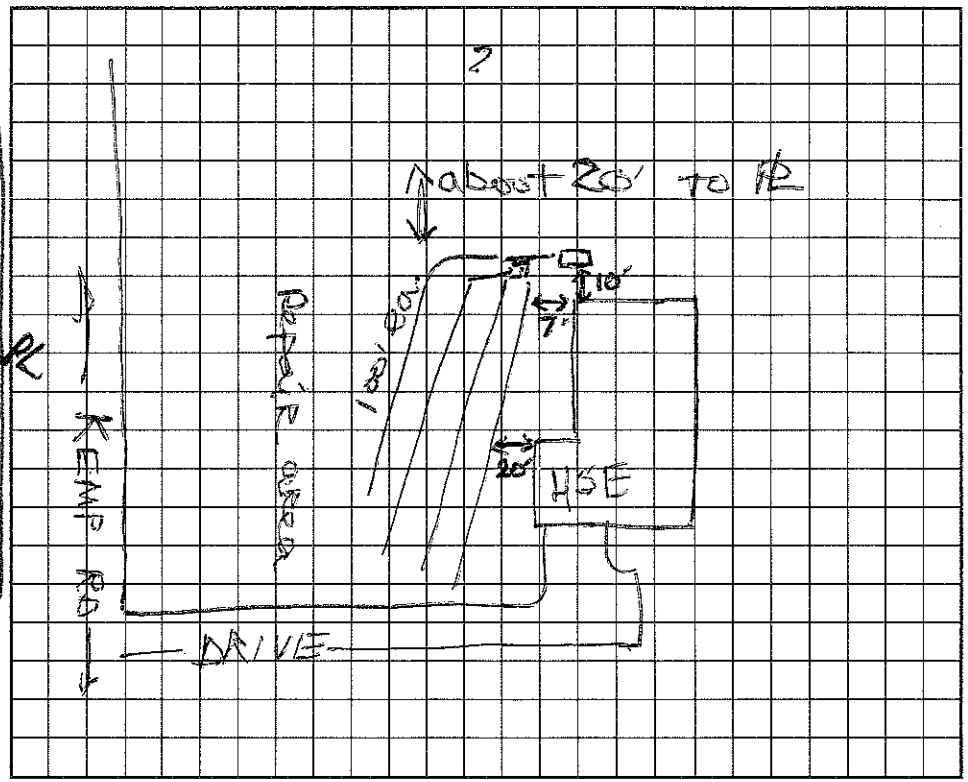

I understand that this permit can be suspended or revoked if any false information is supplied toward securing the permit/any unauthorized changes are made to the site/any unauthorized changes are made in the installation of the system. Improvement Permit is valid for 60 months from date of issuance.

Signed: X

Improvement Permit by: Jamie R. Jamison, RS date 1/11/94

Existing System Inspection by: ____ date ____

Installed by: JULIAN BOWLES

Certificate of Completion by: Andrea Lemon date 6-17-94

Operation Permit by: ____ date ____

HEALTH DEPT. COPY: WHITE INSPECTION COPY (FINAL): GREEN OWNER COPY (FINAL): YELLOW INSPECTION COPY (INITIAL): PINK OWNER COPY (INITIAL): GOLD