IREDELL COUNTY HEALTH DEPARTMENT

STATESVILLE 704-878-5305 MOORESVILLE 704-664-5281

IMPROVEMENT PERMIT / CERTIFICATE OF COMPLETION / OPERATION PERMIT / EXISTING SYSTEM INSPECTION

PROPERTY DESCRIPTION NO. 17754 DATE Aug 29, '94 TAX MAP NO. 2F3B27 Watershed: ☑ Yes ☐ No

OWNER OR CONTRACTOR Scott Whitten PHONE: Business 588-0071 Home

ADDRESS 10428 Riverdale Way, Charlotte, 28273

LOCATION 1600 TR 1115 TR 2nd entrance to Kemp Rd. TR ¼ mile on Rt 4626-05-4216

SUBDIVISION Pine Knoll Pt. BLOCK / SECTION LOT 27 LOT AREA 25,000 Ft² + SITE CLASS. PS pm 1158 DESIGN FLOW 480 gpd L.T.A.R. e 3

Septic Tank: 1000 Gallons; STB 774 Date 11-28-94

Pump Tank: Gallons; PT Date

Pump Make: Model Serial No.

Nitrification Field: No Fields 1 Square Feet 1600 Linear Feet 534

No Lines 4B Trench Width 36" Max Trench Bottom Depth 36" Gravel Depth

☑ New System ☐ Repair System Type: I, II, III, IV, V, VI

System Description: gravity CONVENTIONAL

Repair System Description: gravity PPBPS

Maintenance Agreement Required: ☐ Yes ☑ No

☑ House/Mod. Home No. Bedrooms 4

☐ Mobile Home No. Bathrooms 3

☐ Business No. Employees

☐ Other


☐ Slab ☑ Crawl Space ☐ Basement w/plumbing ☐ Basement wo/plumbing

Water Supply: ☑ Individual ☐ Community ☐ Public

Comments:

Comments: Substantially as shown

INITIAL SITE SKETCH

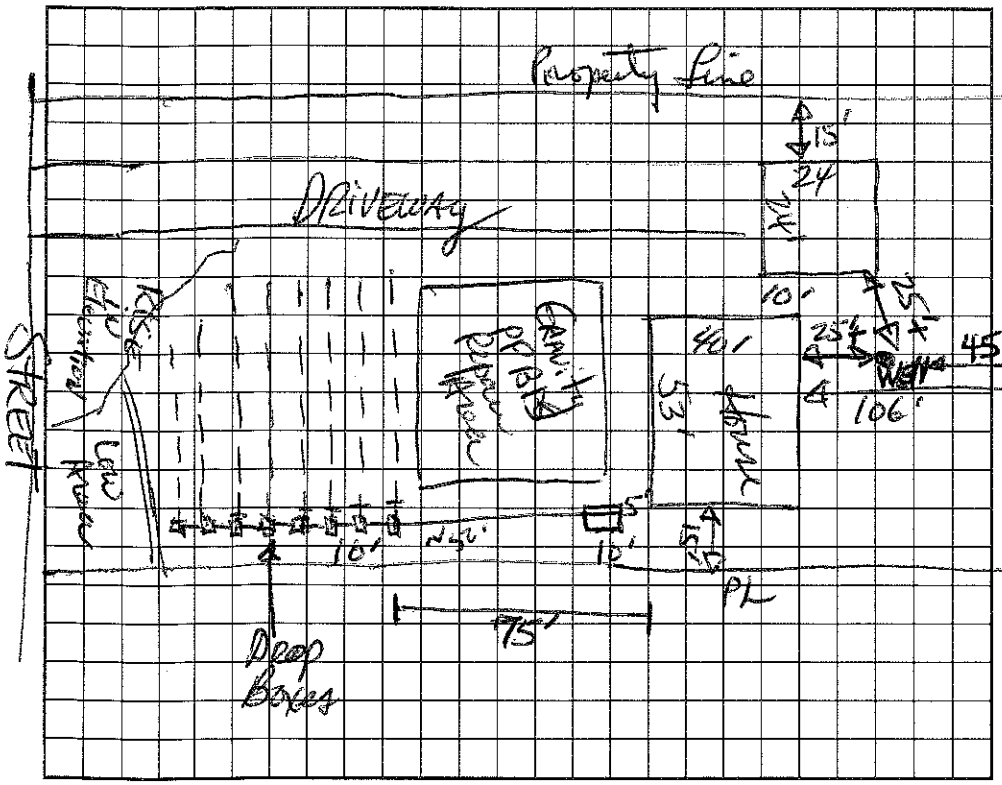

AS BUILT SKETCH

I understand that this permit can be suspended or revoked if any false information is supplied toward securing the permit/any unauthorized changes are made to the site/any unauthorized changes are made in the installation of the system. Improvement Permit is valid for 60 months from date of issuance.

Signed:

Improvement Permit by: Donald R Thomas, RS date 8/29/94

Existing System Inspection by: date

Installed by:

Certificate of Completion by: Donald R Thomas, RS date 1-4-95

Operation Permit by: date

HEALTH DEPT. COPY: WHITE INSPECTION COPY (FINAL): GREEN OWNER COPY (FINAL): YELLOW INSPECTION COPY (INITIAL): PINK OWNER COPY (INITIAL): GOLD