IREDELL COUNTY HEALTH DEPARTMENT

STATESVILLE 704-878-5305 MOORESVILLE 704-664-5281

IMPROVEMENT PERMIT / CERTIFICATE OF COMPLETION / OPERATION PERMIT / EXISTING SYSTEM INSPECTION

PROPERTY DESCRIPTION NO. 15995 DATE Oct. 5, '93 TAX MAP NO. 3F3A 25

OWNER OR CONTRACTOR Rodney Dale Bumgardner PHONE: Business _____ Home 4626-05-5067

ADDRESS _____

LOCATION 1100 Block of 115 to end bear left on Kemp 1/2-3/4 mile on left

SUBDIVISION Pine Knoll Pointe BLOCK / SECTION _____ LOT 25 LOT AREA 30,000 Ft² SITE CLASS. PS A.T.A.R. .35

Water Supply: ☑ Individual ☐ Community ☐ Public

Septic Tank: 1250 Gallons; STB 1013 RST Date 7-4-93

Pump Tank: _____ Gallons; PT _____ Date _____

Nitrification Field: No Fields 1 Square Feet 1050 Linear Feet 350

No Lines 3 Trench Width 36" Trench Depth 24"-36" Gravel Depth 12"

☑ New System ☐ Repair System Type: I, II, III, IV, V, VI

System Description: gravity conventional

Repair System Description: Same

Maintenance Agreement Required: ☐ Yes ☑ No

☑ House/Mod. Home No. Bedrooms 3

☐ Mobile Home No. Bathrooms 2

☐ Business No. Employees _____

☐ Other _____

☐ Slab ☐ Crawl Space ☑ Basement w/plumbing ☐ Basement wo/plumbing

Garbage Disposal: ☑ Yes ☐ No

Auto. Dishwasher: ☑ Yes ☐ No


Auto. Washing Machine: ☑ Yes ☐ No

Other _____

Comments _____

INITIAL SITE SKETCH

AS BUILT SKETCH

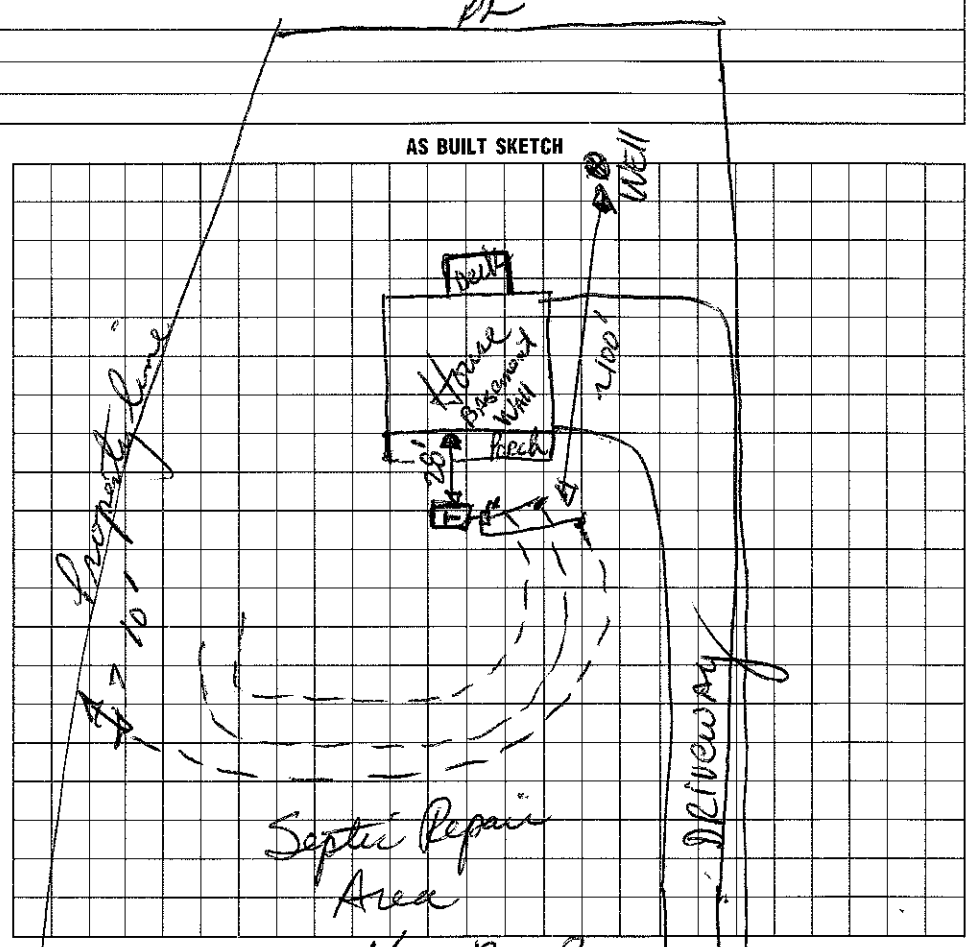

I understand that this permit can be suspended or revoked if any false information is supplied toward securing the permit/any unauthorized changes are made to the site/any unauthorized changes are made in the installation of the system. Improvement Permit is valid for 60 months from date of issuance.

Signed: _____

Improvement Permit by: _____ date _____

Existing System Inspection by: _____ date _____

Installed by: Richard Abernathy

Certificate of Completion by: Jerrell Johnson IRS date 10/5/93

Operation Permit by: _____ date _____

HEALTH DEPT. COPY: WHITE INSPECTION COPY (FINAL): GREEN OWNER COPY (FINAL): YELLOW INSPECTION COPY (INITIAL): PINK OWNER COPY (INITIAL): GOLD