4626056967

IREDELL COUNTY HEALTH DEPARTMENT

STATESVILLE 704-878-5305 MOORESVILLE 704-664-5281

IMPROVEMENT PERMIT / CERTIFICATE OF COMPLETION / OPERATION PERMIT / EXISTING SYSTEM INSPECTION

PROPERTY DESCRIPTION NO. 17884 DATE Feb 25, '94 TAX MAP NO. 2F3A 181 Watershed: ☑ Yes ☐ No

OWNER OR CONTRACTOR Clinton LeDoux PHONE: Business _____ Home _____ L.N.

ADDRESS 7200 Melody Lane Charlotte

LOCATION 1100 TR 1115 R 2nd entrance to Kemp TR ~10th on left

SUBDIVISION Crescent Lake Acres BLOCK / SECTION 8 LOT 181 LOT AREA .87 Ac SITE CLASS. _____ DESIGN FLOW _____ L.T.A.R. _____

Septic Tank: Existing Gallons; STB _____ Date _____

Pump Tank: _____ Gallons; PT _____ Date _____

Pump Make: _____ Model _____ Serial No. _____

Nitrification Field: No Fields Existing Square Feet _____ Linear Feet _____

No Lines _____ Trench Width _____ Max Trench Bottom Depth _____ Gravel Depth _____

☐ New System ☐ Repair System Type: I, II, III, IV, V, VI

System Description: _____

Repair System Description: _____

Maintenance Agreement Required: ☐ Yes ☐ No

☐ House/Mod. Home ☑ Mobile Home ☐ Business ☐ Other _____

No. Bedrooms 2 No. Bathrooms 1½ No. Employees _____


☐ Slab ☐ Crawl Space ☐ Basement w/plumbing ☐ Basement wo/plumbing

Water Supply: ☑ Individual ☐ Community ☐ Public

Comments: Existing system showing no sign of malfunction. Locate replacement 2 bedroom MH at least 5' from septic system.

Comments:

INITIAL SITE SKETCH CAKE NORMAN

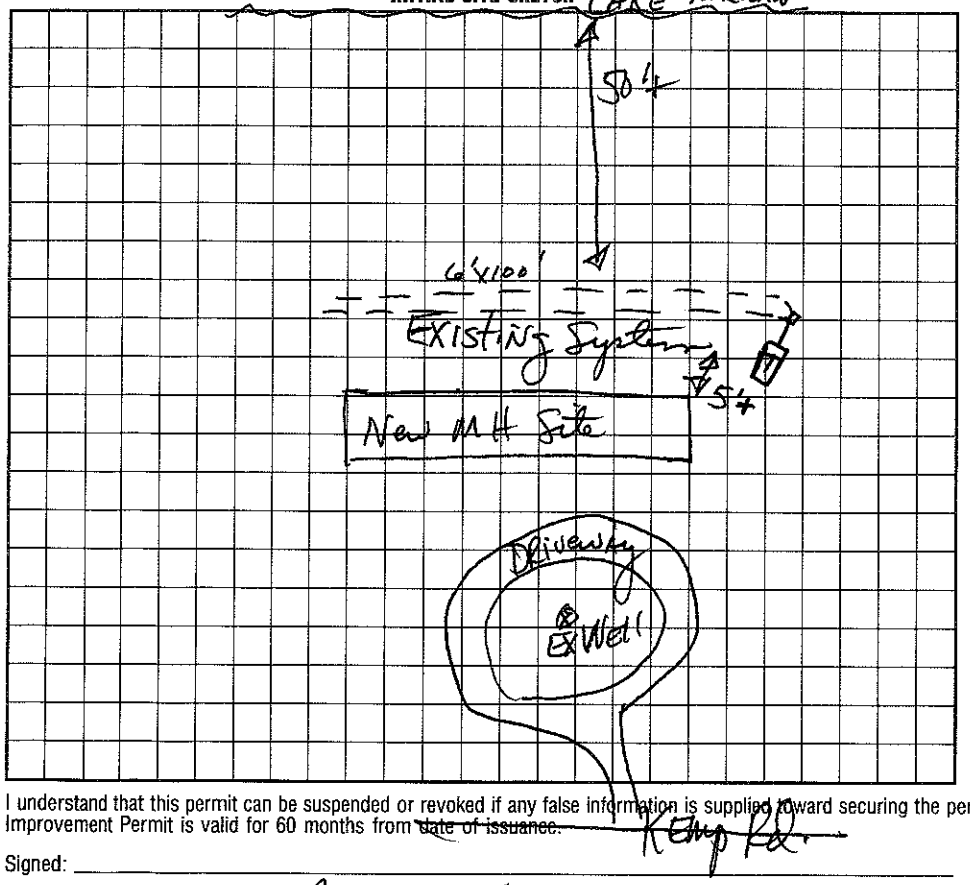

AS BUILT SKETCH

I understand that this permit can be suspended or revoked if any false information is supplied toward securing the permit/any unauthorized changes are made to the site/any unauthorized changes are made in the installation of the system. Improvement Permit is valid for 60 months from ~~date of issuance~~.

Signed: _____

Improvement Permit by: _____ date _____

Existing System Inspection by: Jerry R Hinson, RS date 2/25/94

Installed by: _____

Certificate of Completion by: _____ date _____

Operation Permit by: _____ date _____

HEALTH DEPT. COPY: WHITE INSPECTION COPY (FINAL): GREEN OWNER COPY (FINAL): YELLOW INSPECTION COPY (INITIAL): PINK OWNER COPY (INITIAL): GOLD