IREDELL COUNTY HEALTH DEPARTMENT

STATESVILLE 704-878-5305 MOORESVILLE 704-664-5281

IMPROVEMENT PERMIT / AUTHORIZATION TO CONSTRUCT / OPERATION PERMIT / EXISTING SYSTEM INSPECTION

PERMIT# 086463 PIN# 4626057366 DATE 5/23/2000

OWNER OR CONTRACTOR Michael Kilby PHONE: Business _____ Home 799-2254

ADDRESS 860 Emerson Dr. Mooresville 28115

LOCATION Brawley School Rd. TR McKendree TL Kemp Rd - 831 Kemp Rd.

SUBDIVISION CL&T BLOCK / SECTION 8 LOT 185 LOT AREA .89 Acre SITE CLASS PS DESIGN FLOW 3 L.T.A.R. _____

Septic Tank: Existing Gallons: STB _____ Date _____

Pump Tank: _____ Gallons: PT _____ Date _____

Pump Make: _____ Model _____ Serial No. _____

Nitrification Field: No Fields ____ Square Feet _____ Linear Feet _____

No Lines _____ Trench Width Exist Max Trench Bottom Depth _____ Gravel Depth _____

☐ New System ☐ Repair System Type: I, II, III, IV, V, VI

System Description: Existing Gravity-Conv

Repair System Description: _____

Maintenance Agreement Required: ☐ Yes ☐ No

☐ House/Mod. Home No. Bedrooms 3

☒ Mobile Home No. Bathrooms 2

☐ Business No. Employees ____

☐ Other _____


☐ Slab ☒ Crawl Space ☐ Basement w/plumbing ☐ Basement wo/plumbing

Water Supply: ☒ Individual ☐ Public ☐ Community

Comments:/Conditions: Existing Septic System appears to be functioning okay at time of inspection, No problems Noticed.

Comments:/Conditions: Approved for 3 Bedroom Home

INITIAL SITE SKETCH - Not to Scale

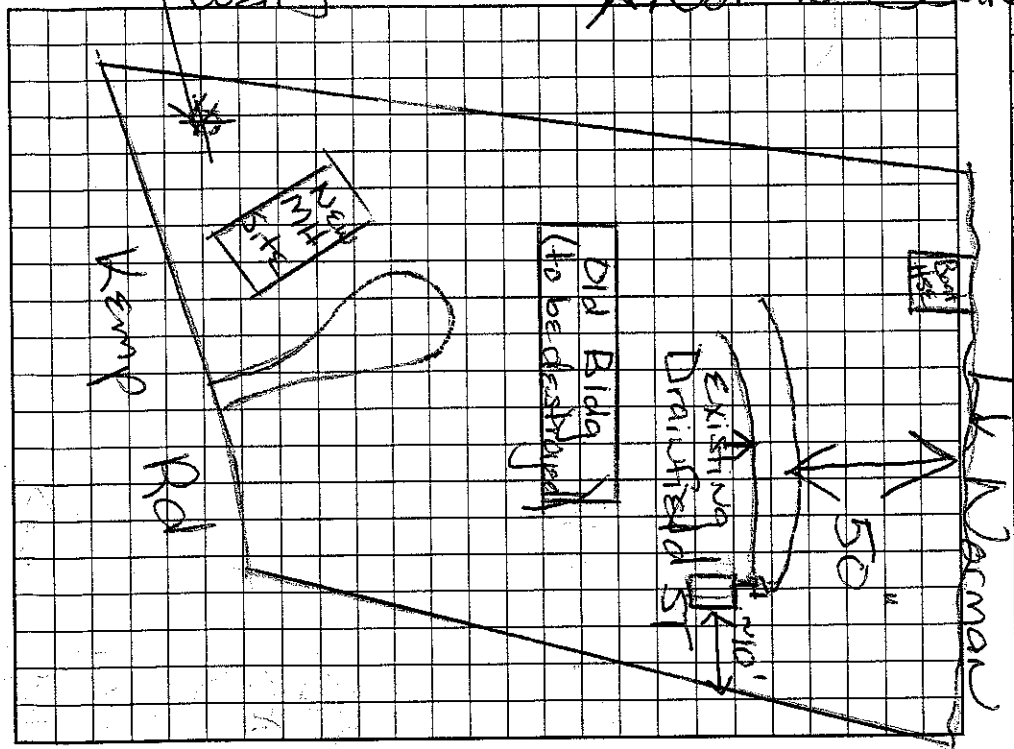

AS BUILT SKETCH

Permit can be suspended or revoked if any false information is supplied toward securing the permit/any unauthorized changes are made to the site/any unauthorized changes are made in the installation of the system. Improvement Permit with plat valid without expiration. Improvement Permit with site plan valid for sixty months. Authorization to Construct is valid for a period equal to that of Improvement Permit – not to exceed sixty months.

Signed: Michael W. Kilby date _____ Installed by: _____

Improvement Permit by: Maria H. Dotson RS date 5/23/2000 Operation Permit by: _____ date _____

Authorization to Construct by: Maria H. Dotson RS date 5/23/2000 Existing System Inspection by: Maria H. Dotson RS date 5/23/2000

HEALTH DEPT. COPY: WHITE OWNER COPY (FINAL): YELLOW OWNER COPY (INITIAL): PINK