INFORMATION FOR THE INSTALLER:

- The permit should be read very carefully prior to bidding. The following are details that must be considered along with all other considerations.
- Tanks shall be approved by NC DENR, and certification supplied by the manufacturer.
- Tanks shall be water tested prior to installation.
- The installer shall be responsible to the owner for placement of the tanks and to insure that final grades are returned to the original natural grade, with exception of added structural features.
- The supply trench shall be compacted to eliminate cavities left during initial fill placement.
- Installation of the system shall be during dry conditions in order to protect the soil structure.
- All fittings shall be pressure rated fittings.
- All joints shall be cleaned with PVC pipe cleaner and a heavy bodied glue applied to weld all joints.
- Where required by the county health department, post installation inspections by the designer must be scheduled 5 week days in advance.
- Trenches shall be carefully excavated so the bottom is within 2" from the highest to . the lowest points of elevation within the trench. If the bottom elevation needs adjusting after it has been trenched, it will be done by removing high points rather than filling low points. It is extremely important to insure that trenches are not over excavated during initial trenching. All fine grading within the trench will be hand done with a shovel. No loose material will be left in the trench
- All pipe openings in the tanks shall be properly grouted. This also applies to the joints around the riser.
- All tanks shall be properly back filled and compacted to prevent slump at a later date.
- Earth dams, constructed of relatively impervious material, shall be installed at the beginning and end of each lateral.
- No heavy equipment shall be used on the field during or after installation. The use of a small loader (i.e. Bobcat) or a trencher (i.e. Ditch Witch 2300/2310) may be used for installation.
- Elevations at pinflag locations should be checked by the installer prior to beginning trenches.
- Pumptank riser should be 6" above grade, control panel should be 12" above grade.
- Septic tank riser shall be a minimum of 6" above finished grade.
- Rake trench walls, lime sidewalls, install trenches 36" wide and have no more than 1/4" fall in 10 feet.

IREDELL COUNTY HEALTH DEPARTMENT

Statesville Phone TR 3-7271 — Mooresville Phone NO 3-1271

PERMIT TO INSTALL SEPTIC TANK

Permit No. _____ Permit Date 29 July 1965

Owner Jerry Stallings Address Charlotte, N.C.

Installed By Carl Dockery Address Mooresville, N.C.

Location of Property Sect 8 Lot 185


125' @.3

Tank		Capacity		Length of Lines		Fixtures	
Block	(✓)	1000	(✓)	225'	(✓)	No. of Baths	( )
Precast	( )	1250	( )	250'	( )	Dishwasher	( )
		1500	( )	Other _____		Garbage Grdr.	( )
		Other _____				Other _____	

NOTIFY HEALTH DEPARTMENT AT LEAST EIGHT HOURS BEFORE TANK IS TO BE INSPECTED.

Final Inspection 29 July 1965 Approved (✓) Disapproved ( )

Remarks _____

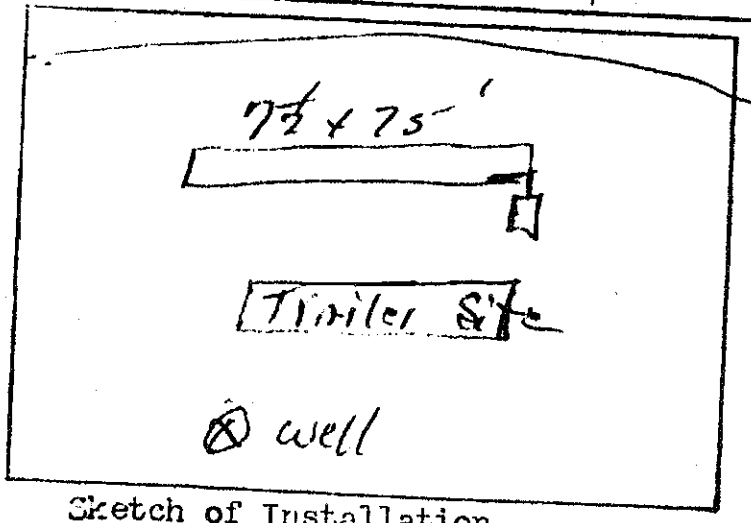

Sketch of Installation

Billy Sessoms
Sanitarian