IREDELL COUNTY HEALTH DEPARTMENT

Auth. to Construct

STATESVILLE 704-878-5305 MOORESVILLE 704-664-5281

IMPROVEMENT PERMIT / ~~CERTIFICATE OF COMPLETION~~ / OPERATION PERMIT / EXISTING SYSTEM INSPECTION

PROPERTY DESCRIPTION NO. 23419 DATE 4/24/96 TAX MAP NO. 2F 3 B 3 Watershed: X Yes ☐ No

OWNER OR CONTRACTOR William H. Miller PHONE: Business _____ Home 662-3762

ADDRESS 745 McKendree Rd. Mooresville, NC 4626-06-2122

LOCATION McKendree Rd. & Brawley Sch. TR on McKendree Rd. 2.5 miles on Left.

SUBDIVISION Pine Knoll Point BLOCK / SECTION _____ LOT 3 LOT AREA .74 AC SITE CLASS PS DESIGN FLOW 360 L.T.A.R. .3

Septic Tank: 1000 Gallons; STB 1012 Date 3/4/99

Pump Tank: _____ Gallons; PT _____ Date _____

Pump Make: _____ Model _____ Serial No. _____

Nitrification Field: No Field Square Feet 1200 Linear Feet 400

No Lines 3 Trench Width 36" Max Trench Bottom Depth 34" Gravel Depth 12"

X New System ☐ Repair System Type: I, II, III, IV, V, VI

System Description: DIST BOX → CONVENTIONAL

Repair System Description: DIST BOX → 16" PPBS

Maintenance Agreement Required: ☐ Yes X No

X House/Mod. Home ☐ Mobile Home ☐ Business ☐ Other

No. Bedrooms 3 No. Bathrooms 3 No. Employees _____


☐ Slab ☐ Crawl Space X Basement w/plumbing ☐ Basement wo/plumbing

Water Supply: X Individual ☐ Community ☐ Public

Comments: Changed to 300' ch-Plastic in approximately same area shown here. REJ. 4/26/99

Comments:

INITIAL SITE SKETCH

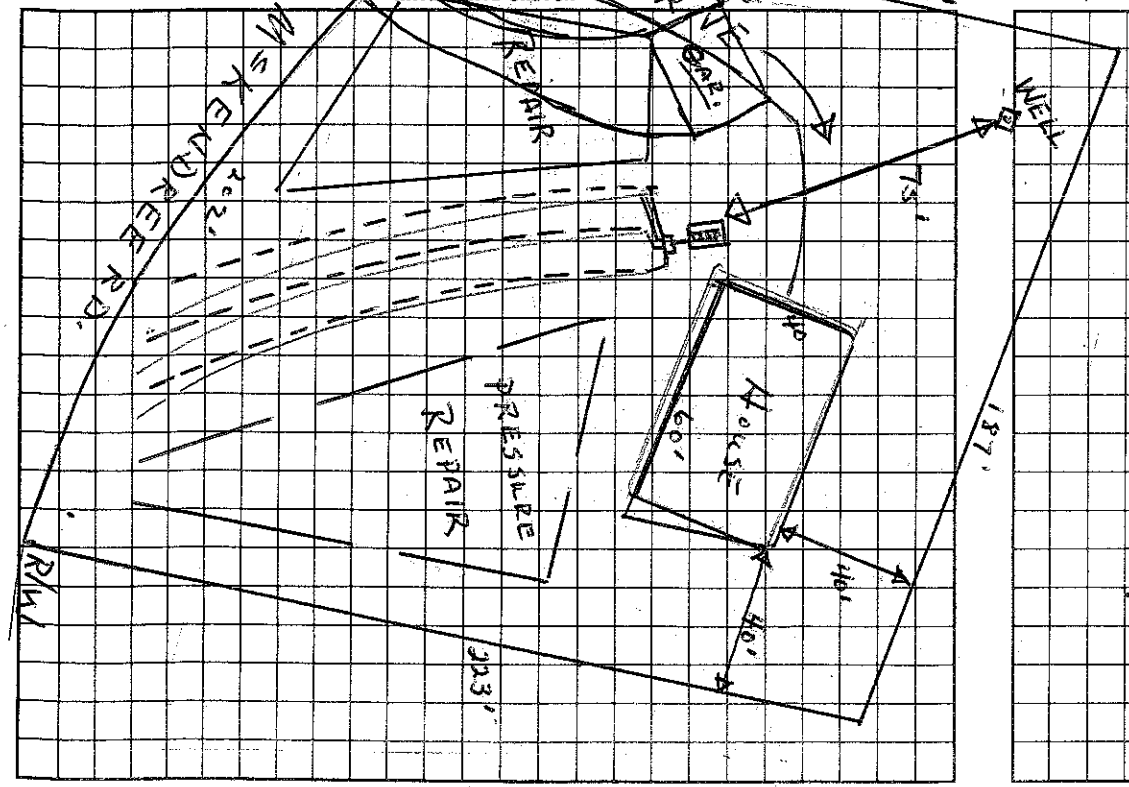

AS BUILT SKETCH

FAXED
ABERNATHY
704-664-6509

I understand that this permit can be suspended or revoked if any false information is supplied toward securing the permit/any unauthorized changes are made to the site/any unauthorized changes are made in the installation of the system.

Auth. to Construct valid 5 years

Signed: William Miller

Improvement Permit by: _____ date _____

Auth. to Construct Existing System Inspection by: Wesley Sparks RS. date 4/24/96

Installed by: Richard Abernathy

Certificate of Completion by: Wesley Sparks RS. date 4/27/99

Operation Permit by: _____ date _____

HEALTH DEPT. COPY: WHITE INSPECTION COPY (FINAL): GREEN OWNER COPY (FINAL): YELLOW INSPECTION COPY (INITIAL): PINK OWNER COPY (INITIAL): GOLD