IREDELL COUNTY HEALTH DEPARTMENT

STATESVILLE 704-878-5305 325.00 Paid MOORESVILLE 704-664-5281 (E)

IMPROVEMENT PERMIT / AUTHORIZATION TO CONSTRUCT / OPERATION PERMIT / EXISTING SYSTEM INSPECTION

PERMIT# 094821 PIN# 4626 06 3516 DATE 3/27/01

OWNER OR CONTRACTOR David Page PHONE: Business _____ Home 660-1614

ADDRESS 126 Greenhill Ln. Mooresville, NC. 28117

LOCATION 1180, TR McKendree on R just beyond 2nd Lakeview Shores Loop intersection

SUBDIVISION CL+T BLOCK / SECTION B LOT 212 LOT AREA ± 1.04 AC SITE CLASS. RS DESIGN FLOW 480 L.T.A.R. .3

Septic Tank: 1000 Gallons; STB 794 Date 9/8/01
Pump Tank: 1000 Gallons; PT 27 Date 9/8/01
Pump Make: Cowles Model WEC-511H Serial No. HD18146
Nitrification Field: No Fields 1 Square Feet 800 Linear Feet 267
No Lines 4@67' Trench Width 36" Max Trench Bottom Depth 36" Gravel Depth NO/SAND

☒ New System ☐ Repair System Type: I, II, III, (IV) V, VI
System Description: LAP - 16" PPBPS
Repair System Description: < 1983
Maintenance Agreement Required: ☒ Yes ☐ No

☒ House/Mod. Home ☐ Mobile Home ☐ Business ☐ Other
No. Bedrooms 4 No. Bathrooms 4 No. Employees ____


☐ Slab ☐ Crawl Space ☒ Basement w/plumbing ☐ Basement wo/plumbing

Water Supply: ☒ Individual ☐ Public ☐ Community

Comments:/Conditions: Improvement Permit Only.

Comments:/Conditions: 2/26/02 System installed for custom home project. Garage is all being utilized at present time. AWS.

INITIAL SITE SKETCH (1" = 60')

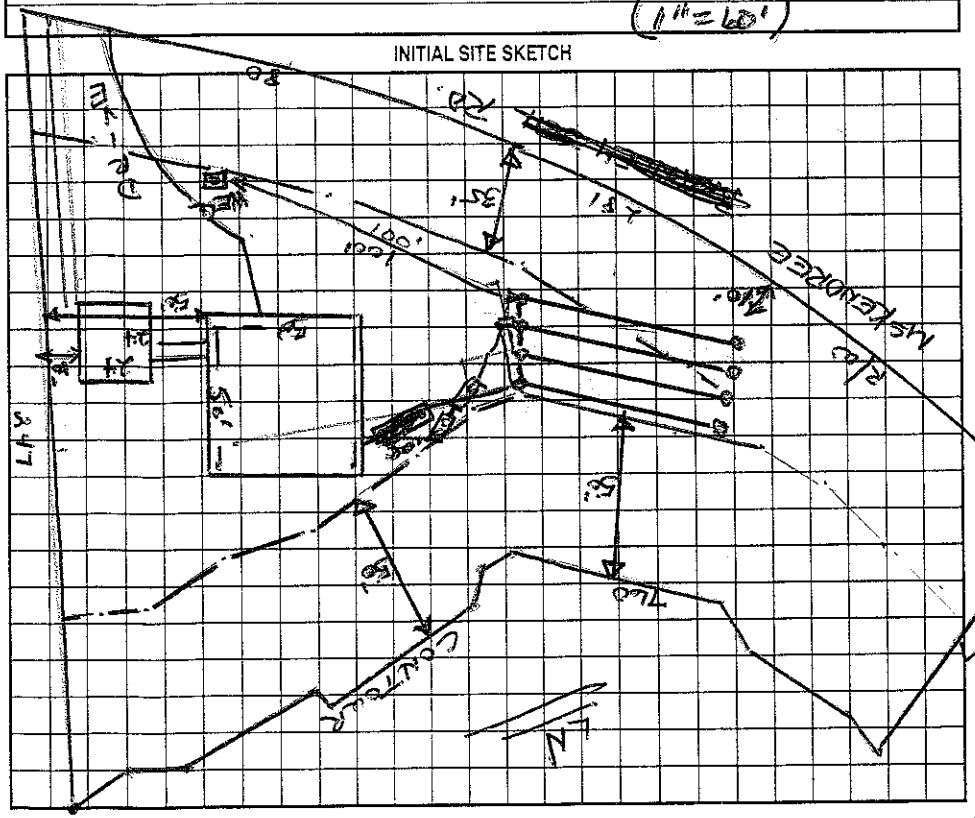

AS BUILT SKETCH

Permit can be suspended or revoked if any false information is supplied toward securing the permit/any unauthorized changes are made to the site/any unauthorized changes are made in the installation of the system. Improvement Permit with plat valid without expiration. Improvement Permit with site plan valid for sixty months. Authorization to Construct is valid for a period equal to that of Improvement Permit – not to exceed sixty months.

Signed: * (Ruth Sparks) date 3/28/01
Improvement Permit by: Wesley Sparks RS. date 3/27/01
Authorization to Construct by: Wesley Sparks RS. date 9/7/01

Installed by: Dobson Const Co.
Operation Permit by: Wesley Sparks RS date 2/26/02
Existing System Inspection by: _____ date _____

HEALTH DEPT. COPY: WHITE OWNER COPY (FINAL): YELLOW OWNER COPY (INITIAL): PINK