IREDELL COUNTY HEALTH DEPARTMENT

Statesville Office (704) 878-5305 — 3625 PERMIT # 205272

IMPROVEMENT PERMIT / AUTHORIZATION TO CONSTRUCT / OPERATION PERMIT / EXISTING SYSTEM

PIN # 4624 06 3516

APPLICANT: Ruthea & David Page APPLICANT ADDRESS: 686 McKendree Mooresville, NC 28117

SITE ADDRESS: 686 McKendree Rd - Mrsvl. PHONE: ALT. PHONE:

SITE DIRECTIONS: Brawley School Rd TR McKendree on right just past 2nd Lakeview Shores Lp.

SUBDIVISION: C & T SECTION: 8 LOT # 212 LOT AREA: ~1.04 Ac DESIGN FLOW: 480 gpd L.T.A.R.: .3

Existing

Septic Tank	1000 (gal)	STB	794	Date	9/8/01	☐ New System ☐ Repair ☐ Expansion	System Type: I II III IV V VI	☒ Residence	No. Bedrooms 4
Pump Tank	1000 (gal)	PT	27	Date	9/8/01	System Description:	Existing L-Panel Block	☐ Business	No. Persons 8
Pump Make		Model		Serial #		Repair System Description:	Needed prior to 1983	☐ Other	No. Employees
# Nitrification Fields	1	# Lines	4	Linear Ft:	267'	Maintenance Agreement Required:	☒ YES ☐ NO	☐ Slab	☐ Crawl Space
Trench Width		Max. Trench Bottom Depth	36"	Gravel Depth	N/A		☐ GRAVITY ☒ PRESSURE	☒ Basement w/plumbing	☐ Basement w/o plumbing


Water Supply: ☒ Private ☐ Public ☐ Community

Comments / Conditions: Existing Septic System appears to be functioning ok at time of inspection. *Current Contract attached


Proposed addition does not appear to impact the existing septic system

INITIAL SITE SKETCH

Scale 1:60

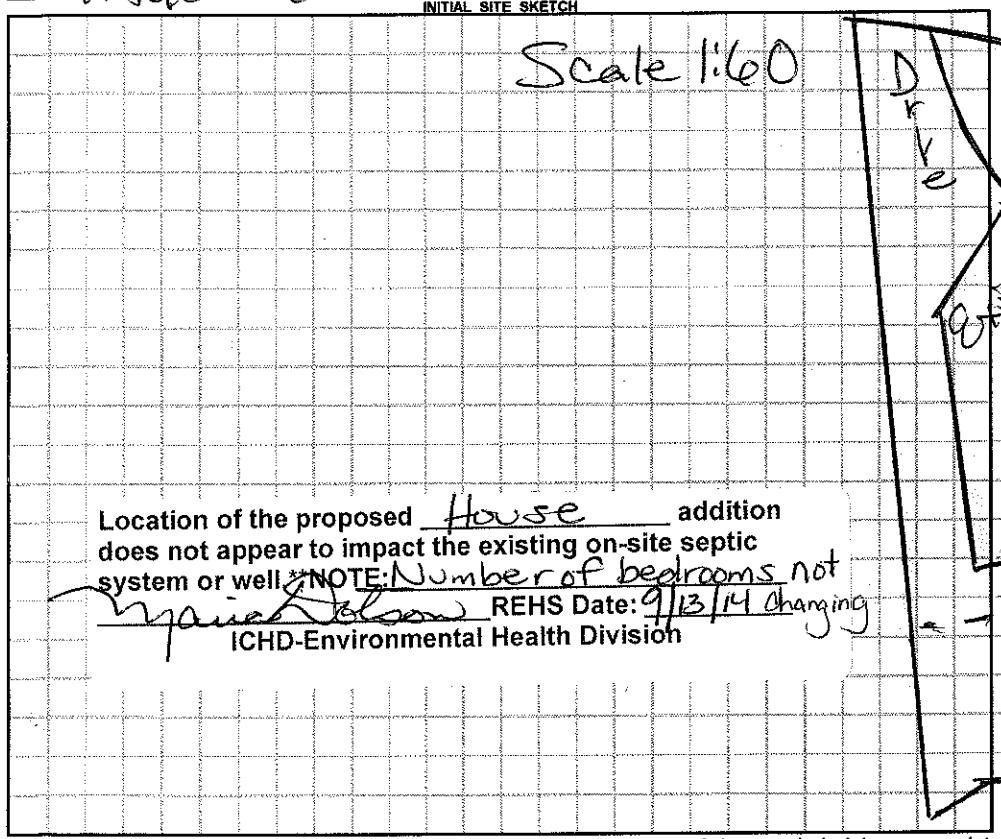

AS BUILT SKETCH

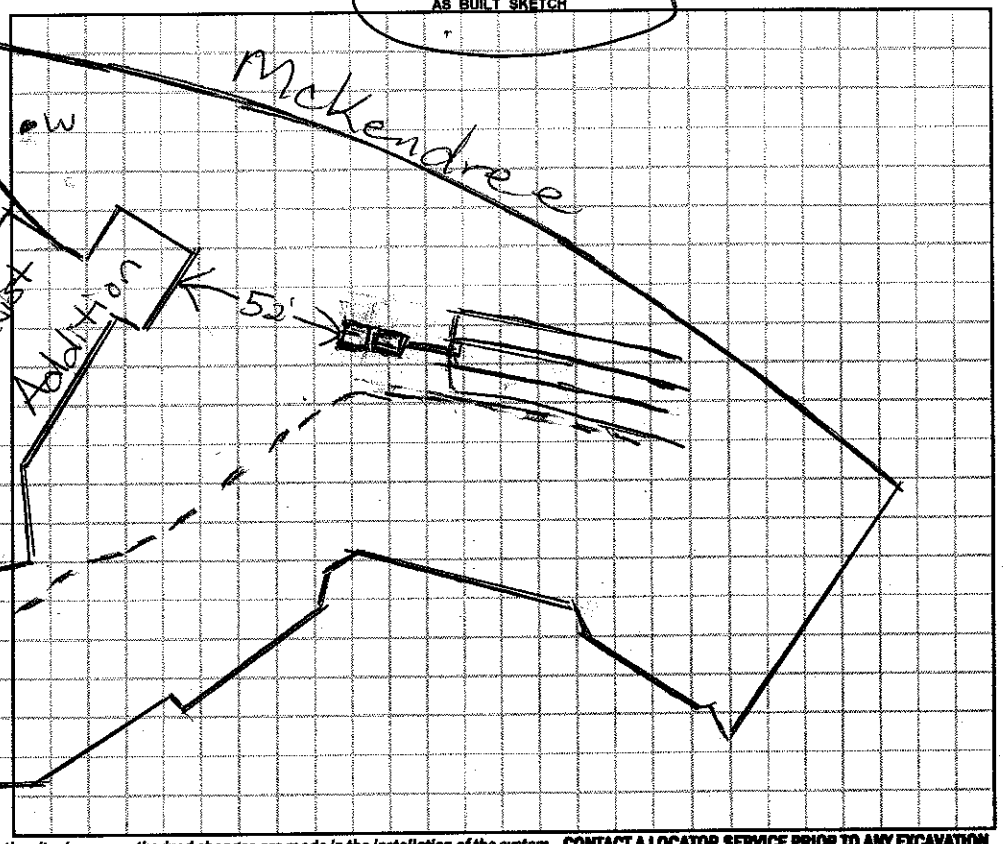

Location of the proposed House addition does not appear to impact the existing on-site septic system or well. *NOTE: Number of bedrooms not changing

Maria Dobson REHS Date: 9/13/14

ICHD-Environmental Health Division

Permit can be suspended or revoked if any false information is supplied toward securing the permit / any unauthorized changes are made to the site / any unauthorized changes are made in the installation of the system. **CONTACT A LOCATOR SERVICE PRIOR TO ANY EXCAVATION**

☐ **IMPROVEMENT PERMIT** *with plat valid without expiration.* ☐ **IMPROVEMENT PERMIT** *with site plan valid for 60 mos.* ☐ **AUTHORIZATION TO CONSTRUCT** *valid for period equal to IMPROVEMENT PERMIT--not to exceed 60 mo.*

Owner / Applicant Signature: Ruthea Page Date: 8/30/16 Installed by: C.W Orbison Grading

IMPROVEMENT PERMIT by: Date: OPERATION PERMIT by: Date:

AUTHORIZATION TO CONSTRUCT by: Date: Existing System Inspected by: Maria Dobson Date: 8/30/16

Health Dept. Copy - WHITE Applicant (Final Approval) - YELLOW Applicant (Conditional Approval) - PINK