IREDELL COUNTY HEALTH DEPARTMENT

AUTHORIZATION TO CONSTRUCT

STATESVILLE 704-878-5305 MOORESVILLE 704-664-5281

IMPROVEMENT PERMIT / ~~CERTIFICATE OF COMPLETION~~ / OPERATION PERMIT / EXISTING SYSTEM INSPECTION

PROPERTY DESCRIPTION NO. 066938 DATE 6/9/97 TAX MAP NO. 4626064132 Watershed: ☑ Yes ☐ No

OWNER OR CONTRACTOR RICHARD EMERY JR PHONE: Business _____ Home 599-5630

ADDRESS 6218 WATERFORD HILLS DR CHARLOTTE NC 28269

LOCATION BRAWLEY SCHOOL - TR MCKENDREE - TL 2ND KEMP - TR KEMP ABAEN RT

SUBDIVISION PINE KNOLL PT BLOCK / SECTION _____ LOT 33 LOT AREA .71 AC SITE CLASS. RS DESIGN FLOW 360 GPD L.T.A.R. .3 GPD/FT²

Septic Tank: 1000 Gallons; STB 825 Date 10/19/97

Pump Tank: _____ Gallons; PT _____ Date _____

Pump Make: _____ Model _____ Serial No. _____

Nitrification Field: No Fields 1 Square Feet 900 Linear Feet 300

No Lines 3 @ 100' Trench Width 36" Max Trench Bottom Depth 36" Gravel Depth N/A

☑ New System ☐ Repair System Type: I, II, (III), IV, V, VI

System Description: GRAVITY CHAMBERED OR SIMILAR

Repair System Description: GRAVITY PANEL

Maintenance Agreement Required: ☐ Yes ☑ No

☑ House/Mod. Home No. Bedrooms 3

☐ Mobile Home No. Bathrooms 2

☐ Business No. Employees ____

☐ Other _____


☐ Slab ☑ Crawl Space ☐ Basement w/plumbing ☐ Basement wo/plumbing

Water Supply: ☑ Individual ☐ Community ☐ Public


Comments:

Comments:

INITIAL SITE SKETCH

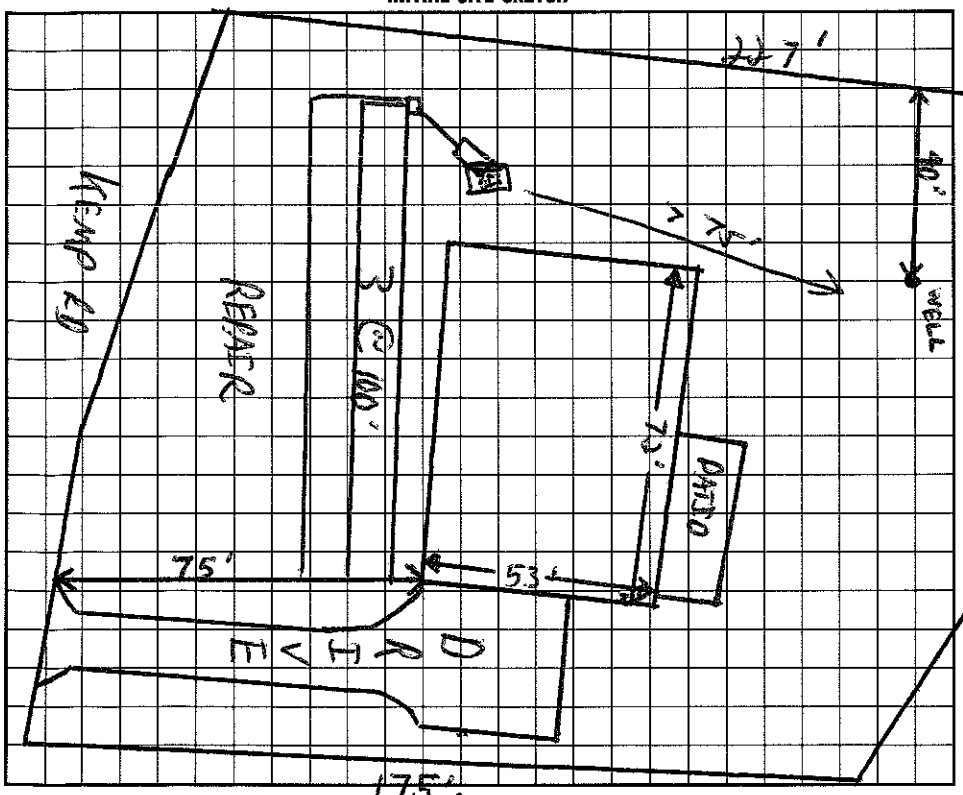

AS BUILT SKETCH

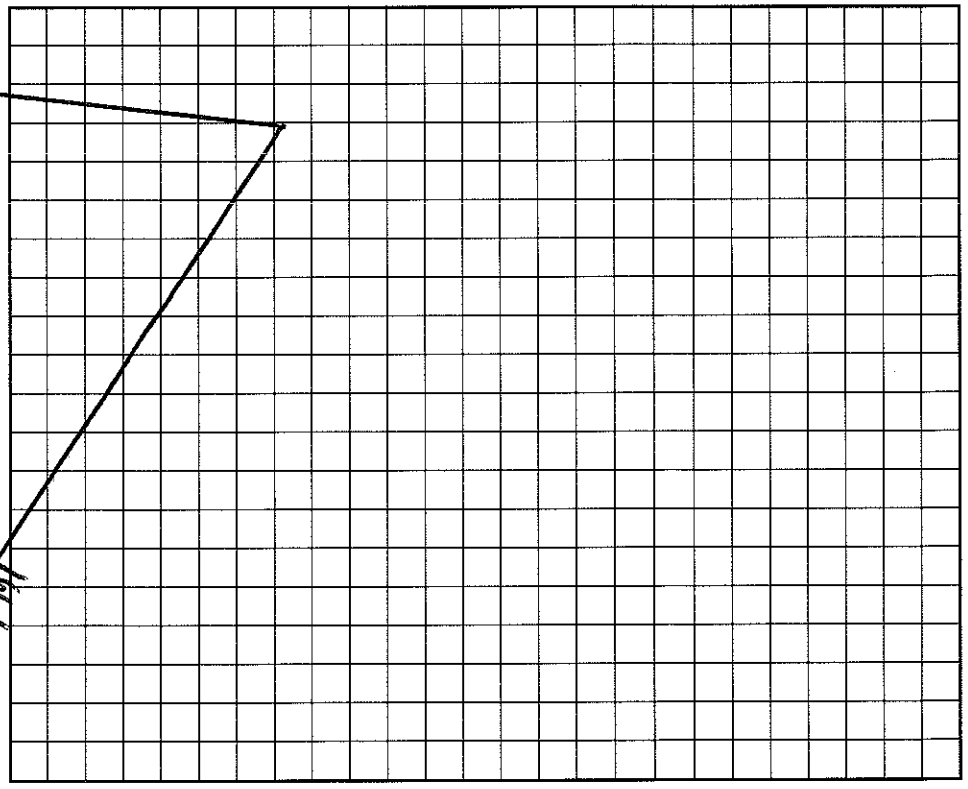

I understand that this permit can be suspended or revoked if any false information is supplied toward securing the permit/any unauthorized changes are made to the site/any unauthorized changes are made in the installation of the system. Improvement Permit is valid for 60 months from date of issuance.

Signed: Richard Emery Jr

Improvement Permit by: C. Ray Fearn date 6/13/97

~~Existing System Inspection by:~~ Authorization C. Ray Fearn date 6/13/97 to Construct

Installed by: Barry Thompson

Certificate of Completion by: Wesley Sparks RS date 12/15/97

Operation Permit by: Wesley Sparks RS date 12/15/97

HEALTH DEPT. COPY: WHITE INSPECTION COPY (FINAL): GREEN OWNER COPY (FINAL): YELLOW INSPECTION COPY (INITIAL): PINK OWNER COPY (INITIAL): GOLD