IREDELL COUNTY HEALTH DEPARTMENT

Statesville Phone TR 3-7271 Mooresville Phone No. 664-5281

PERMIT TO INSTALL SEPTIC TANK

Permit No. 244 Permit Date 9-27- 1973

Owner Charlie Marshal Address Kannapolis

Installed By Kannapolis Service Address Kannapolis


Location of Property 1100 TR on 1115 3mi TL Then TR on 1455, (Sec 8 Jot 178) ⇦ ½ mi on left

Tank		Capacity		Length of Lines		Fixtures	
Block	( )	1000	(✓)	225'	(✓)	No. of Baths	(2)
Precast	(✓)	1250	( )	250'	( )	Dishwasher	(1)
		1500	( )	Other		Garbage Grdr.	(1)
		Other				Other Washing Machine	

NOTIFY HEALTH DEPARTMENT AT LEAST EIGHT HOURS BEFORE TANK IS TO BE INSPECTED.

Final Inspection 9-27-1973 Approved (✓) Disapproved ( )

Remarks well not on property at time of inspection

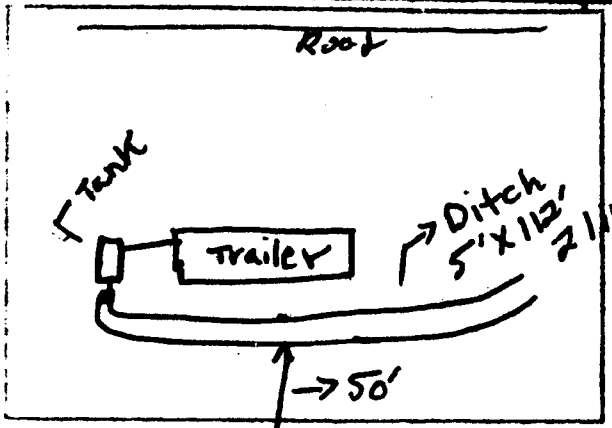

Sketch of Installation

J. C. Moore

Sanitarian