IREDELL COUNTY HEALTH DEPARTMENT

IMPROVEMENT PERMIT / AUTHORIZATION TO CONSTRUCT / OPERATION PERMIT / EXISTING SYSTEM INSPECTION

STATESVILLE 704-878-5305 250.00 Paid (Ammons)(330-400) MOORESVILLE 704-664-5281

PERMIT# 081414 PIN# 4626067208

OWNER OR CONTRACTOR Barry Gardner DATE 2/10/2001

ADDRESS 605 Wellington Rd PHONE: Business (336) 760-5014 Home (336) 725-7002

LOCATION Brawley School Rd TR Winston Salem

SUBDIVISION C&T BLOCK / SECTION 8 LOT 179 LOT AREA SITE CLASS PS DESIGN FLOW 480gpd L.T.A.R. .34

McKendree TC Kemp (2nd) TR 179 Kemp

Septic Tank: 1000 Gallons; STB 794 Date 10-29-00

Pump Tank: 1000 Gallons; PT 283 Date 1-12-01

Pump Make: Myers Model Mett Serial No.

Nitrification Field: No. Fields 1 Square Feet 795 Linear Feet 265'

No Lines 5 Trench Width 24"-36" Max Trench Bottom Depth 30" Gravel Depth N/A

☒ New System ☐ Repair System Type: I, II, III, IV, V, VI

System Description: LP-Pump-Panel Blk

Repair System Description: Same

Maintenance Agreement Required: ☒ Yes ☐ No

☒ House/Mod. Home No. Bedrooms 4

☐ Mobile Home No. Bathrooms 3.5

☐ Business No. Employees

☐ Other


☐ Slab ☐ Crawl Space ☒ Basement w/plumbing ☐ Basement wo/plumbing

Water Supply: ☒ Individual ☐ Public ☐ Community


Comments:/Conditions: Keep Septic System at least 10' From PL 5' From House, 50' From lake. Must be 50' From any well.

Comments:/Conditions: Note: Very tight site. Divert Stormwater/Surface water away/around drainfield. Polyjak filter, drilled 5/32 hole

INITIAL SITE SKETCH

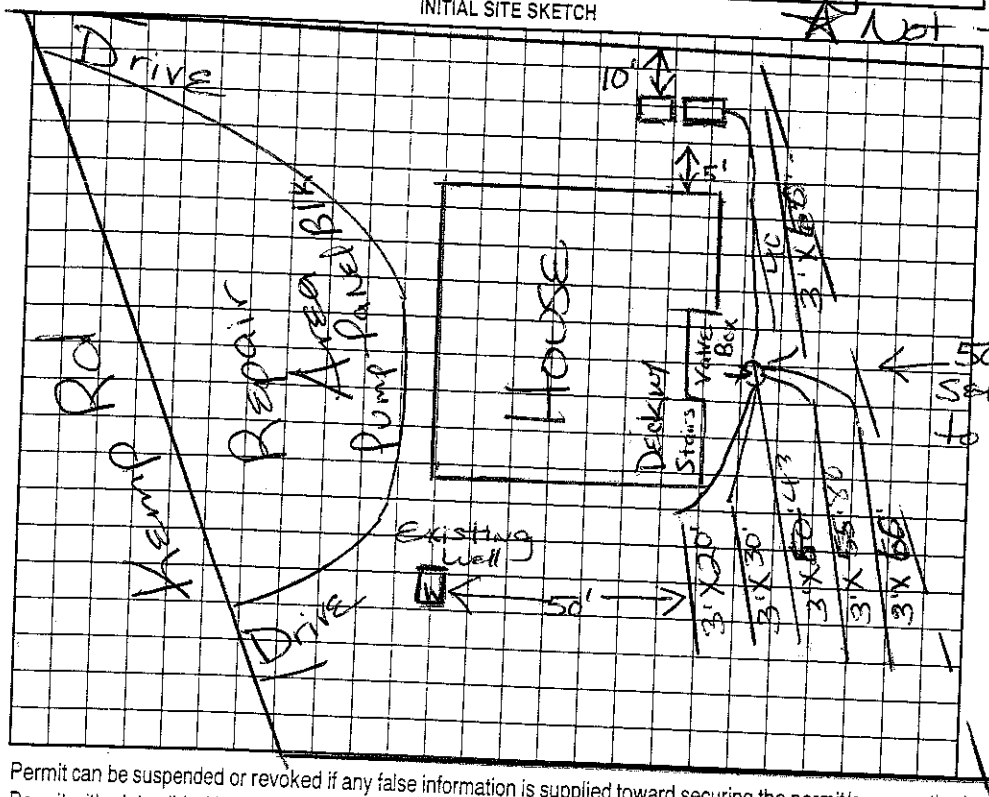

AS BUILT SKETCH

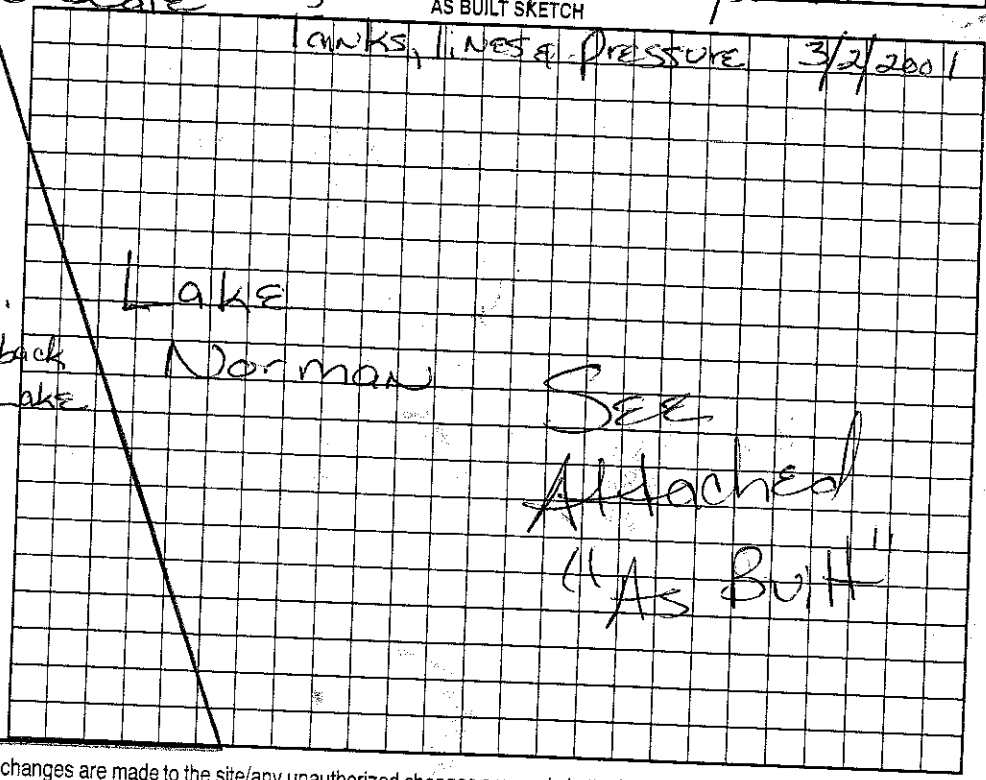

Permit can be suspended or revoked if any false information is supplied toward securing the permit/any unauthorized changes are made to the site/any unauthorized changes are made in the installation of the system. Improvement Permit with plat valid without expiration. Improvement Permit with site plan valid for sixty months. Authorization to Construct is valid for a period equal to that of Improvement Permit – not to exceed sixty months.

Signed: Brent Alexander date 2-13-01 Installed by: Tim Ammons

Improvement Permit by: Maria H. Dolan RS date 2/10/2001 Operation Permit by: Maria H. Dolan RS date 3/15/2001

Authorization to Construct by: Maria H. Dolan RS date 2/10/2001 Existing System Inspection by: date

HEALTH DEPT. COPY: WHITE OWNER COPY (FINAL): YELLOW OWNER COPY (INITIAL): PINK