★ Revised/As Built

IREDELL COUNTY HEALTH DEPARTMENT

STATESVILLE 704-878-5305 MOORESVILLE 704-664-5281

IMPROVEMENT PERMIT / AUTHORIZATION TO CONSTRUCT / OPERATION PERMIT / EXISTING SYSTEM INSPECTION

PERMIT# 144105 PIN# 4626067726 DATE 7-26-07

OWNER OR APPLICANT Craig Carter, Builder, Inc PHONE: Business 336-940-2341 Home

ADDRESS 157 Yadkin Valley Rd Advance NC 27006

LOCATION Brawley School Rd TR McKendree TL 2nd Kemp Rd on left Address 753 Kemp

SUBDIVISION C L & T BLOCK / SECTION 8 LOT 176 LOT AREA .82 Ac SITE CLASS. AS DESIGN FLOW 360gpd L.T.A.R. .25 gpd/ft²

Septic Tank: 1000 Gallons: STB Date

Pump Tank: 1000 Gallons: PT Date

Pump Make. Model Serial No.

Nitrification Field: No Fields 1 Square Feet Linear Feet 240

No Lines 4 Trench Width 24" min. Max Trench Bottom Depth 36" Gravel Depth NA ☐ Gravity ☒ Pressure

☒ New System ☐ Repair ☐ Expansion System Type: I II III IV V VI

System Description: LP Panel

Repair System Description: LP Panel

Maintenance Agreement Required: ☒ Yes ☐ No

☒ House/Mod. Home ☐ Mobile Home ☐ Business ☐ Other

No. Bedrooms 3 No. Persons 6 No. Employees

Water Supply: ☒ Individual ☐ Public ☐ Community


☐ Slab ☐ Crawl Space ☒ Basement w/plumbing ☐ Basement wo/plumbing

Comments/Conditions: ★ Before OP properly abandon existing well by licensed well driller & submit documentation to Health Dept.
- House site includes side load garage area


Comments/Conditions: OK to install in 3 lines #1-78 #2-72 #3-96
- Attempted to design around trees but may need to remove to install system properly
- Keep supply line 10' from building 3-192 2-72 1-78

INITIAL SITE SKETCH

1" = 50'

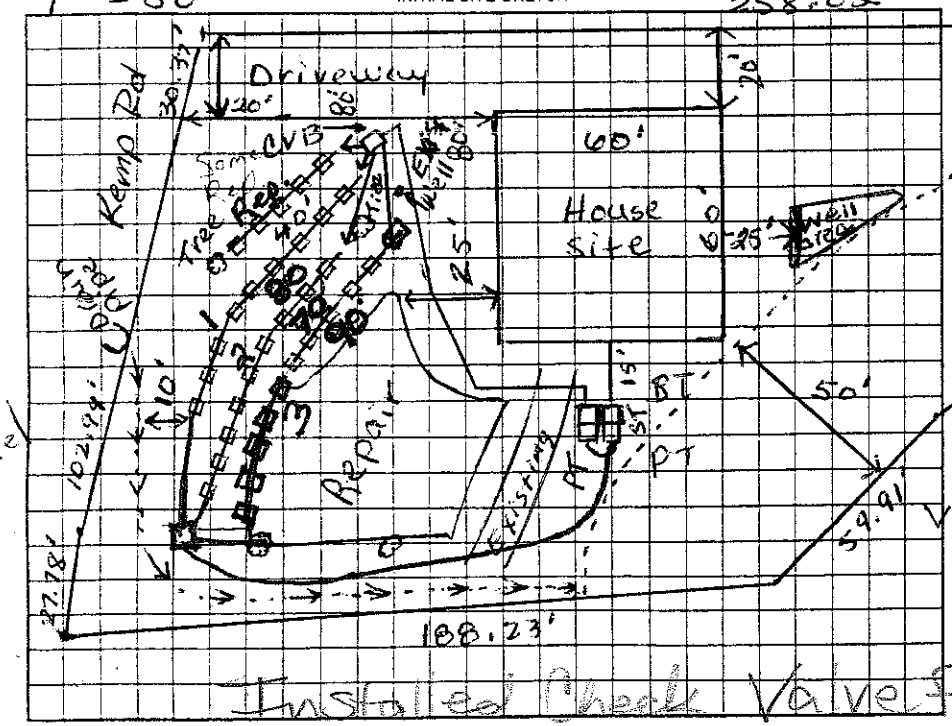

AS BUILT SKETCH

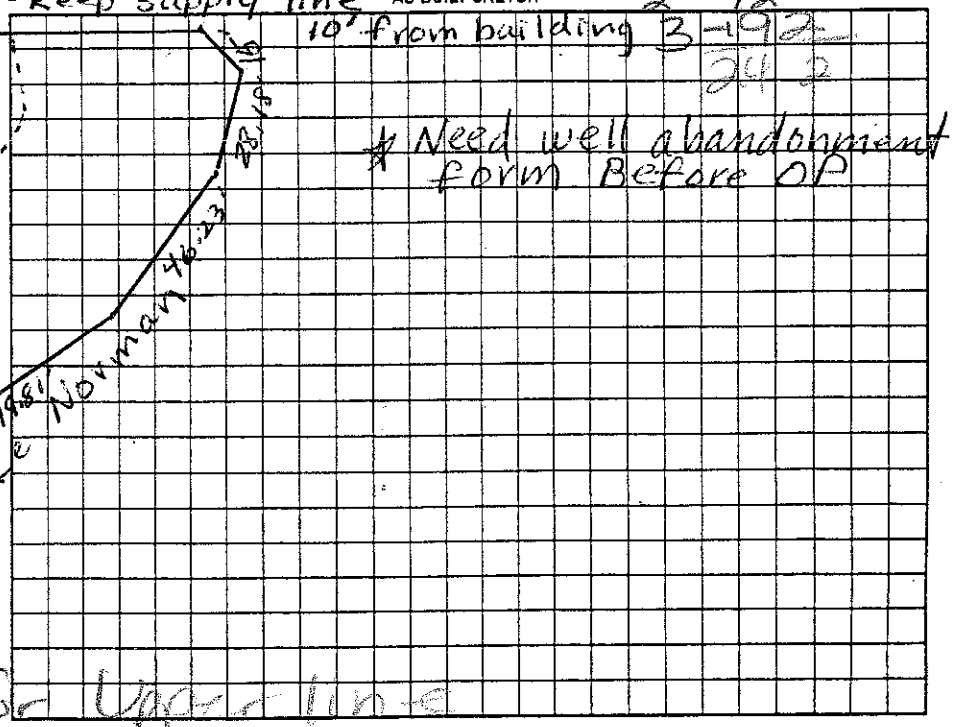

Tanks set parallel

Installed Check Valve for Uphill

Permit can be suspended or revoked if any false information is supplied toward securing the permit/any unauthorized changes are made to the site/any unauthorized changes are made in the installation of the system. Improvement Permit with plat valid without expiration ☐ Improvement Permit with site plan valid for sixty months ☒ Authorization to Construct is valid for a period equal to that of Improvement Permit – not to exceed sixty months.

Signed: Craig C. Carter date 7-27-07 Installed by: Richard Abernathy

Improvement Permit by: Judy Melville date 7-26-07 Operation Permit by: Maine Hill Olsen date

Authorization to Construct by: Judy Melville date 8-11-07 Existing System Inspection by: date

HEALTH DEPT. COPY: WHITE OWNER COPY (FINAL): YELLOW OWNER COPY (INITIAL): PINK