PT 3-18-09

# IREDELL COUNTY HEALTH DEPARTMENT

STATESVILLE 704-878-5305 MOORESVILLE 704-664-5281

## IMPROVEMENT PERMIT / AUTHORIZATION TO CONSTRUCT / OPERATION PERMIT / EXISTING SYSTEM INSPECTION

PERMIT# 144105 PIN# 4626067726 / Ross & Sue Gerdon DATE 7-26-07

OWNER OR APPLICANT Craig Carter, Builder, Inc. PHONE: Business 336-940-2341 Home

ADDRESS 157 Yadkin Valley Rd Advance NC 27006

LOCATION Brawley School Rd TR McKendree TL 2nd Kemp Rd on left Address 753 Kemp

SUBDIVISION CL&T BLOCK / SECTION 8 LOT 176 LOT AREA .82 Ac SITE CLASS. PS DESIGN FLOW 360gpd L.T.A.R. .25 gpd/ft²

Septic Tank: 1000 Gallons; STB 794 Date 7-28-09
Pump Tank: 1000 Gallons; PT 283 Date 3-18-09
Pump Make: Hydromatic Model SHEF45M Serial No.
Nitrification Field: No Fields 1 Square Feet Linear Feet 240
No Lines 4 Trench Width 24" min. Max Trench Bottom Depth 36" Gravel Depth NA ☐ Gravity ☒ Pressure

☒ New System ☐ Repair ☐ Expansion System Type: I II III ⓘV V VI
System Description: LP Panel
Repair System Description: LP Panel
Maintenance Agreement Required: ☒ Yes ☐ No

☒ House/Mod. Home ☐ Mobile Home ☐ Business ☐ Other
No. Bedrooms 3 No. Persons 6 No. Employees


Water Supply: ☒ Individual ☐ Public ☐ Community

☐ Slab ☐ Crawl Space ☒ Basement w/plumbing ☐ Basement wo/plumbing


Comments:/Conditions: * Before OP properly abandon existing well by licensed well driller & submit documentation to Health Dept.
- House site includes side load garage area
1" = 50'

Comments:/Conditions:
- Attempted to design around trees but may need to remove to install system properly (3) Trees
- Keep supply line 10' from building

INITIAL SITE SKETCH

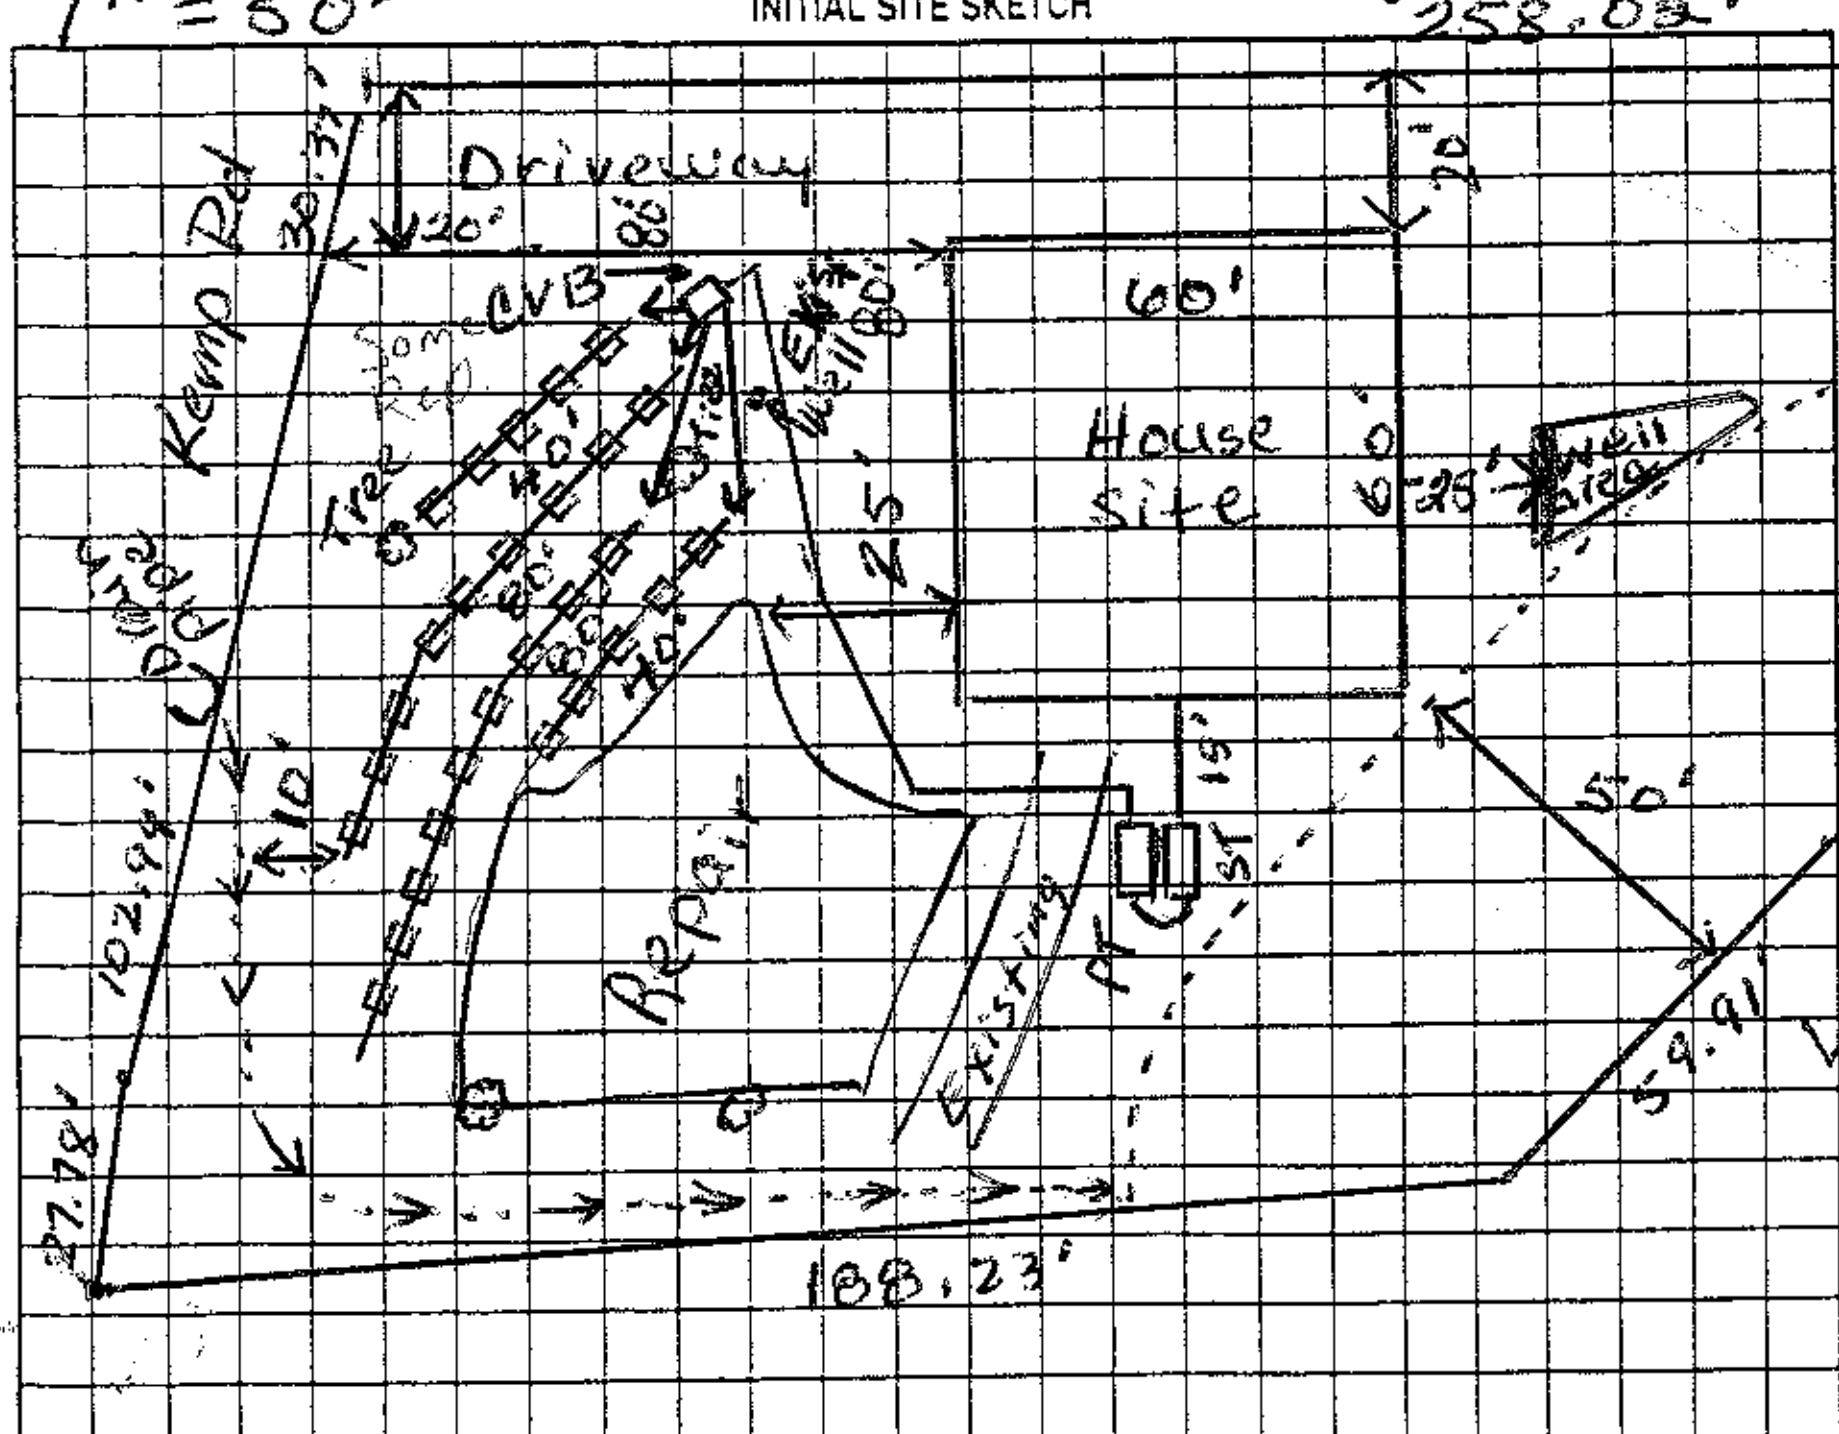


AS BUILT SKETCH

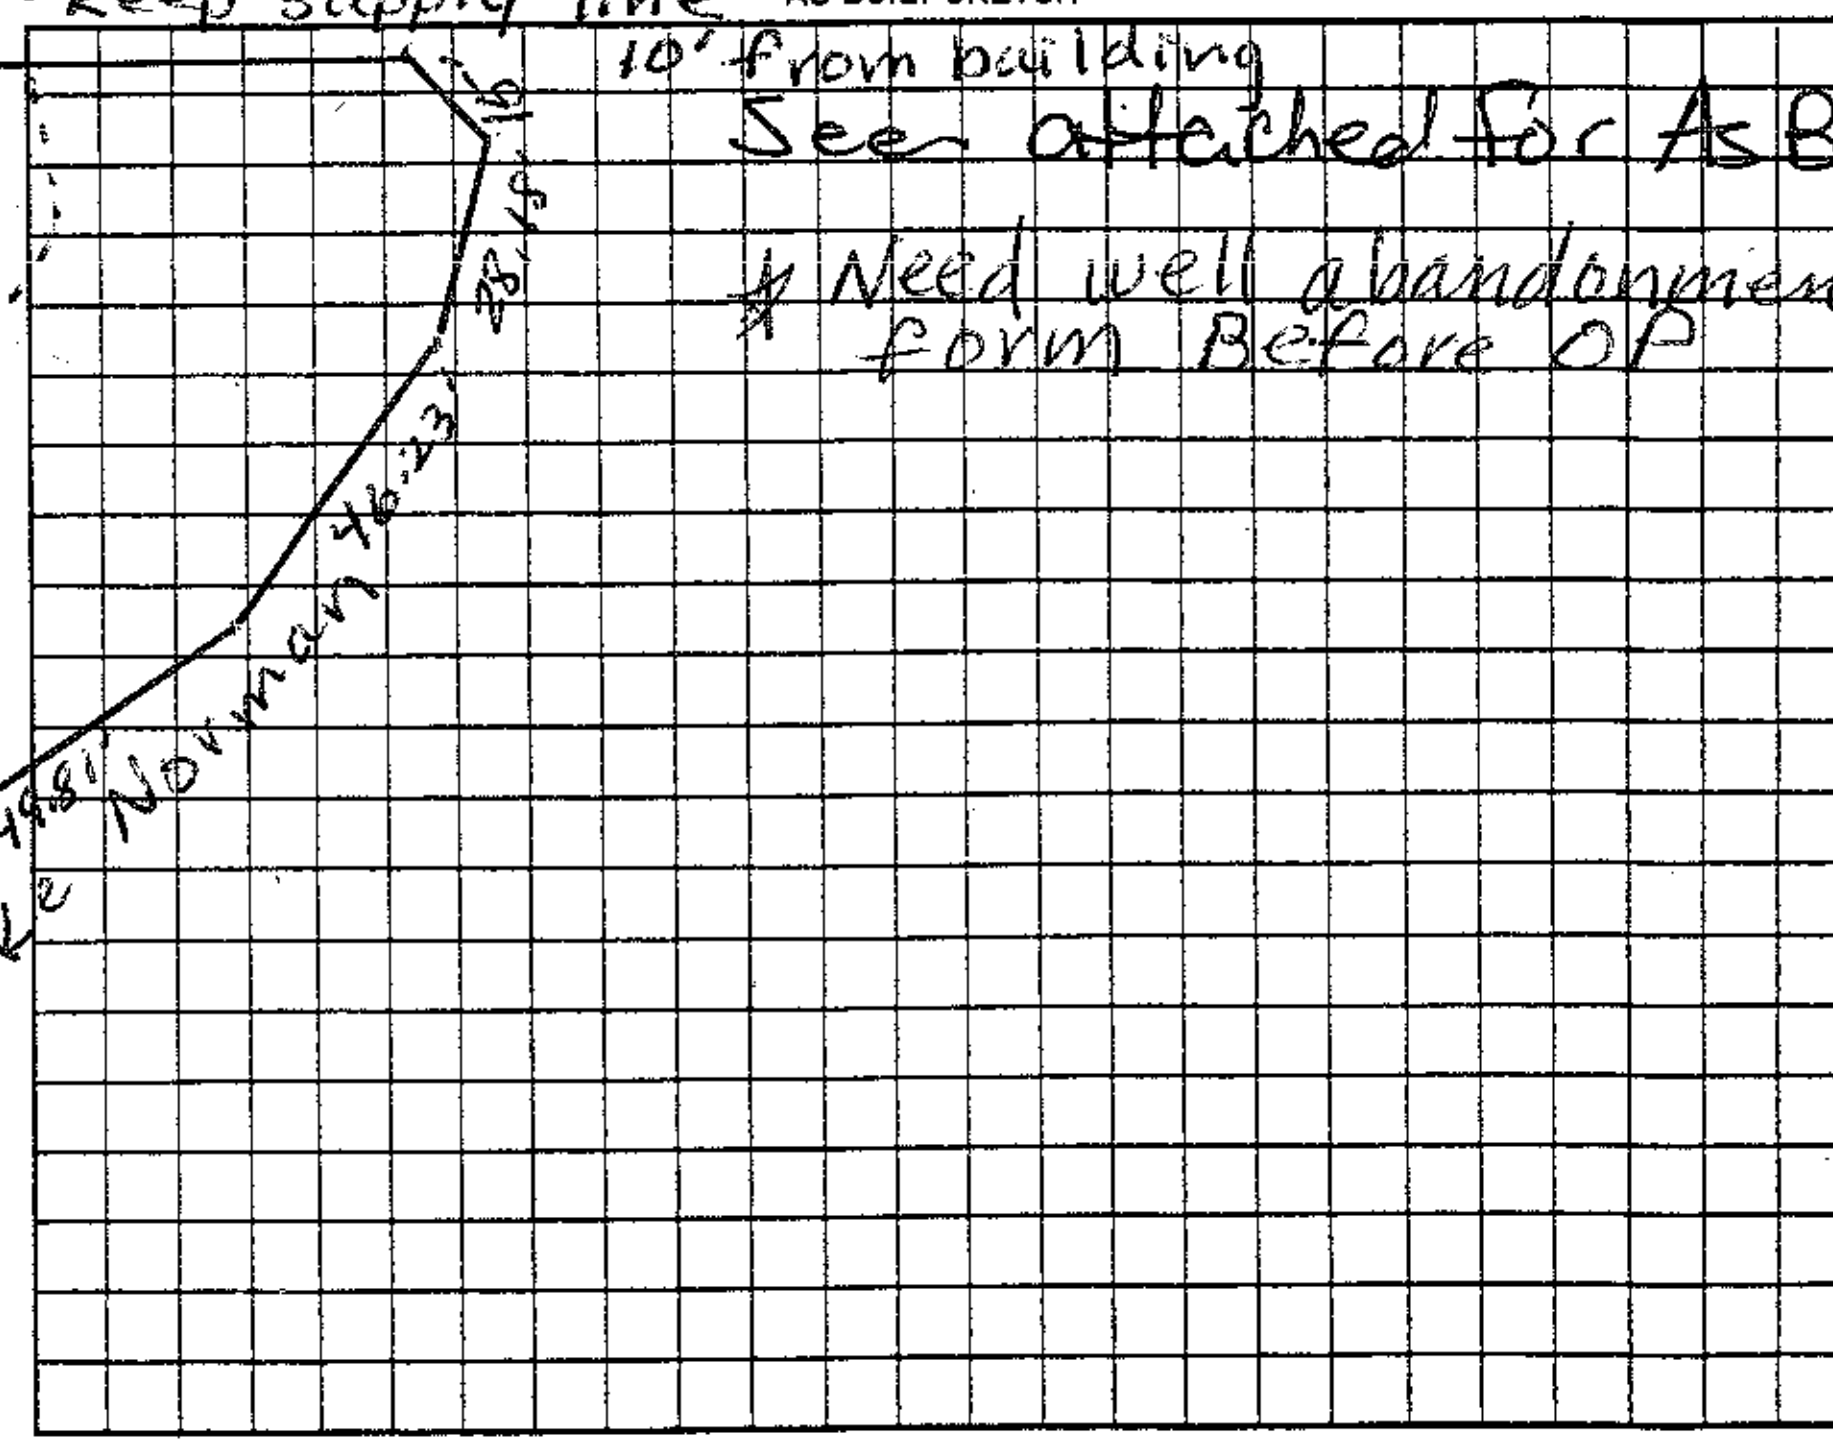


Permit can be suspended or revoked if any false information is supplied toward securing the permit/any unauthorized changes are made to the site/any unauthorized changes are made in the installation of the system. Improvement Permit with plat valid without expiration ☐ Improvement Permit with site plan valid for sixty months ☒ Authorization to Construct is valid for a period equal to that of Improvement Permit – not to exceed sixty months.

Signed: Craig A. Carter Jr date 7-27-07
Installed by: Richard Abernathy
Improvement Permit by: Judy Melville date 7-26-07
Operation Permit by: [signature] date 3/30/2010
Authorization to Construct by: Judy Melville date 9-11-07
Existing System Inspection by: date

HEALTH DEPT. COPY: WHITE OWNER COPY (FINAL): YELLOW OWNER COPY (INITIAL): PINK