4:30

IREDELL COUNTY HEALTH DEPARTMENT

Statesville Office (704) 878-5305 Mooresville Office (704) 660-3625 PERMIT # 131237

IMPROVEMENT PERMIT / AUTHORIZATION TO CONSTRUCT / OPERATION PERMIT / EXISTING SYSTEM

PIN # 4626074929

APPLICANT: KGG BUILDERS APPLICANT ADDRESS: 145 WATERVIEW DR MOORESVILLE, NC 28117

SITE ADDRESS: SPEARS CREEK PHONE: ALT. PHONE:

SITE DIRECTIONS: BRAWLEY SCHOOL - TR McKENDREE - TR SPEARS CREEK - 1ST ON RT

SUBDIVISION: THE FARMS SECTION: 4 LOT # 472 LOT AREA: .912AC DESIGN FLOW: 600 L.T.A.R.: .25

Septic Tank 1500 (gal) STB 390 Date 6-12
Pump Tank (gal) PT Date
Pump Make Model Serial #
Nitrification Fields 1 # Lines 4 Linear Ft: 600
Trench Width 36" Max. Trench Bottom Depth 36" Gravel Depth N/A

☑ New System ☐ Repair ☐ Expansion System Type: I II (III) IV V VI
System Description: GRAVITY 25% REDUCTION
Repair System Description: LPPBPS
Maintenance Agreement Required: ☐ YES ☑ NO
☑ GRAVITY ☐ PRESSURE

☑ Residence No. Bedrooms 5
☐ Business No. Persons 10
☐ Other No. Employees
☐ Slab ☑ Crawl Space
☐ Basement w/plumbing ☐ Basement w/o plumbing

Water Supply: ☐ Private ☐ Public ☑ Community


Comments / Conditions:

INITIAL SITE SKETCH

SEE KATHLEEN SAUNDER'S LSS PLAN

AS BUILT SKETCH

1 25
2 26
3 26
4 25
5 25
6 23

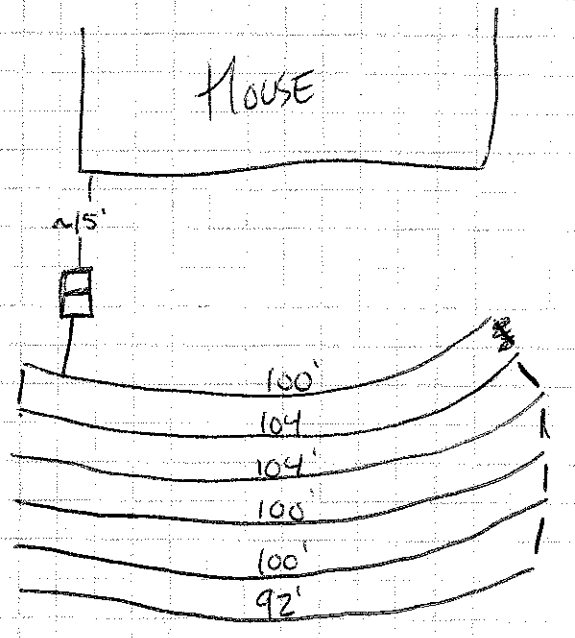

Permit can be suspended or revoked if any false information is supplied toward securing the permit / any unauthorized changes are made to the site / any unauthorized changes are made in the installation of the system. **CONTACT A LOCATOR SERVICE PRIOR TO ANY EXCAVATION**

☐ **IMPROVEMENT PERMIT** *with plat valid without expiration.* ☑ **IMPROVEMENT PERMIT** *with site plan valid for 60 mos.* ☑ **AUTHORIZATION TO CONSTRUCT** *valid for period equal to IMPROVEMENT PERMIT--not to exceed 60 mo.*

Owner / Applicant Signature: Kathleen Saunders Date: 7/24/13 Installed by: A-1 BACKHOE

IMPROVEMENT PERMIT by: [signature] ARMS Date: 7/22/13 OPERATION PERMIT by: RA Date: 10-28-13

AUTHORIZATION TO CONSTRUCT by: [signature] ARMS Date: 7/22/13 Existing System Inspected by: Date:

Health Dept. Copy - WHITE Applicant (Final Approval) - YELLOW Applicant (Conditional Approval) - PINK