Owner: Richard / Jessica Hauser

IREDELL COUNTY HEALTH DEPARTMENT

Statesville Office (704) 878-5305 Mooresville Office (704) 660-3625 PERMIT # 211031

IMPROVEMENT PERMIT / AUTHORIZATION TO CONSTRUCT / OPERATION PERMIT / EXISTING SYSTEM

PIN # 4626-07-6106

APPLICANT: Crescent Communities LLC APPLICANT ADDRESS:


SITE DIRECTIONS: Brawley Sch Rd, TR on McKendree, Lot on L Past 2nd Kemp

SUBDIVISION: Crescent Communities SECTION: — LOT # -1- LOT AREA: 1.473ac DESIGN FLOW: 480gpd L.T.A.R.: 0.3

Septic Tank	1000 (gal)	STB 825	Date 10-11-15	☑ New System	☐ Repair	☒ Expansion	System Type: I II ☑III IV V VI	☑ Residence	No. Bedrooms	4	Water Supply
Pump Tank	— (gal)	PT —	Date —	System Description:	Gravity 25% Reduction			☐ Business	No. Persons	8	☑ Private
Pump Make	—	Model —	Serial # —	Repair System Description:	LP PPBPS			☐ Other	No. Employees	—	☐ Public
# Nitrification Fields	1	# Lines 4	Linear Ft: 400'	Maintenance Agreement Required:	☐ YES	☑ NO		☑ Slab	☐ Crawl Space		☐ Community
Trench Width	36"	Max. Trench Bottom Depth	36"	Gravel Depth	N/A	☑ GRAVITY	☐ PRESSURE	☐ Basement w/plumbing		☐ Basement w/o plumbing	

Comments / Conditions: 8/31/15 Reviewed Floor plans, in Compliance with Septic plan.

A Do not grade down for house pad. Must build house as shown on Septic plan. (Driveway opposite of Septic System)

INITIAL SITE SKETCH

1-20-16 KB

SEE DESIGN BY

THE OAKS GROUP


(Approved 6-9-15 AZP)
(Revision to site plan 1-12-16 + floor plans AZP)

AS BUILT SKETCH

Rowan Septic Tank Mid-seam 1000 gallon Septic (concrete) w/ a Tuff-Tite EF. 6 Filter
Exit tank @ 4'6"

1	120'	4'	10.5"
2	116	4'	9"
3	108	5'	3"
4	58'	5'	7"

9' on centers

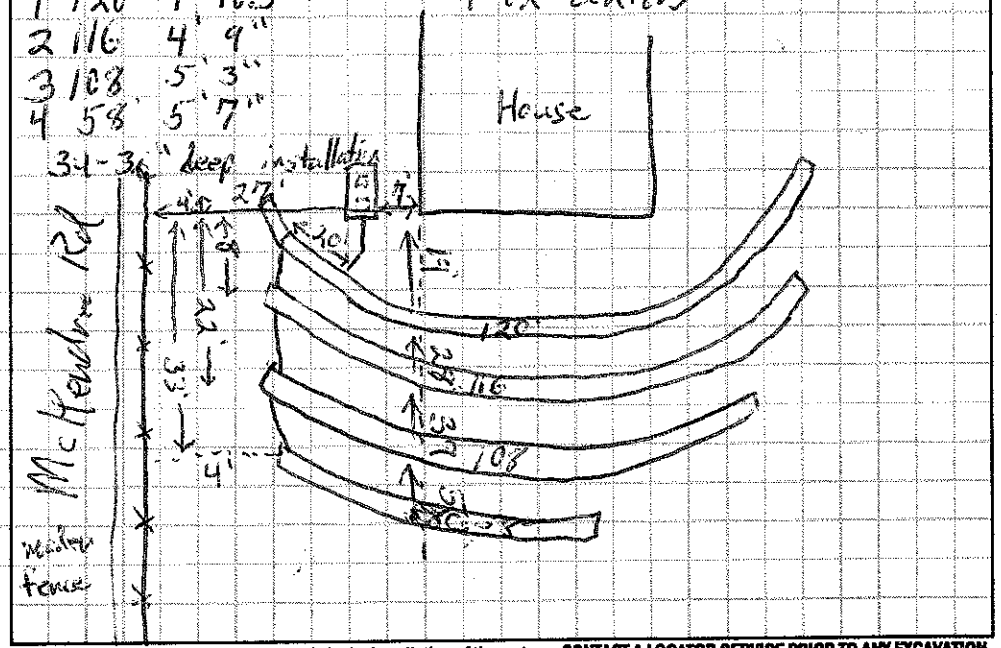

Permit can be suspended or revoked if any false information is supplied toward securing the permit / any unauthorized changes are made to the site / any unauthorized changes are made in the installation of the system. **CONTACT A LOCATOR SERVICE PRIOR TO ANY EXCAVATION**

☐ **IMPROVEMENT PERMIT** *with plat valid without expiration.* ☑ **IMPROVEMENT PERMIT** *with site plan valid for 60 mos.* ☒ **AUTHORIZATION TO CONSTRUCT** *valid for period equal to IMPROVEMENT PERMIT--not to exceed 60 mo.*


Owner / Applicant Signature: Emma Holt Date: 6-10-15 Installed by: Rowan Septic [Kevin Kirkpatrick]

IMPROVEMENT PERMIT by: [illegible] Date: 6-5-15 OPERATION PERMIT by: Sam Church Date: 1-21-16

AUTHORIZATION TO CONSTRUCT by: Maria H. Dalton RS Date: 8/31/15 Existing System Inspected by: Date:

AZP 1-12-16

Health Dept. Copy - WHITE Applicant (Final Approval) - YELLOW Applicant (Conditional Approval) - PINK

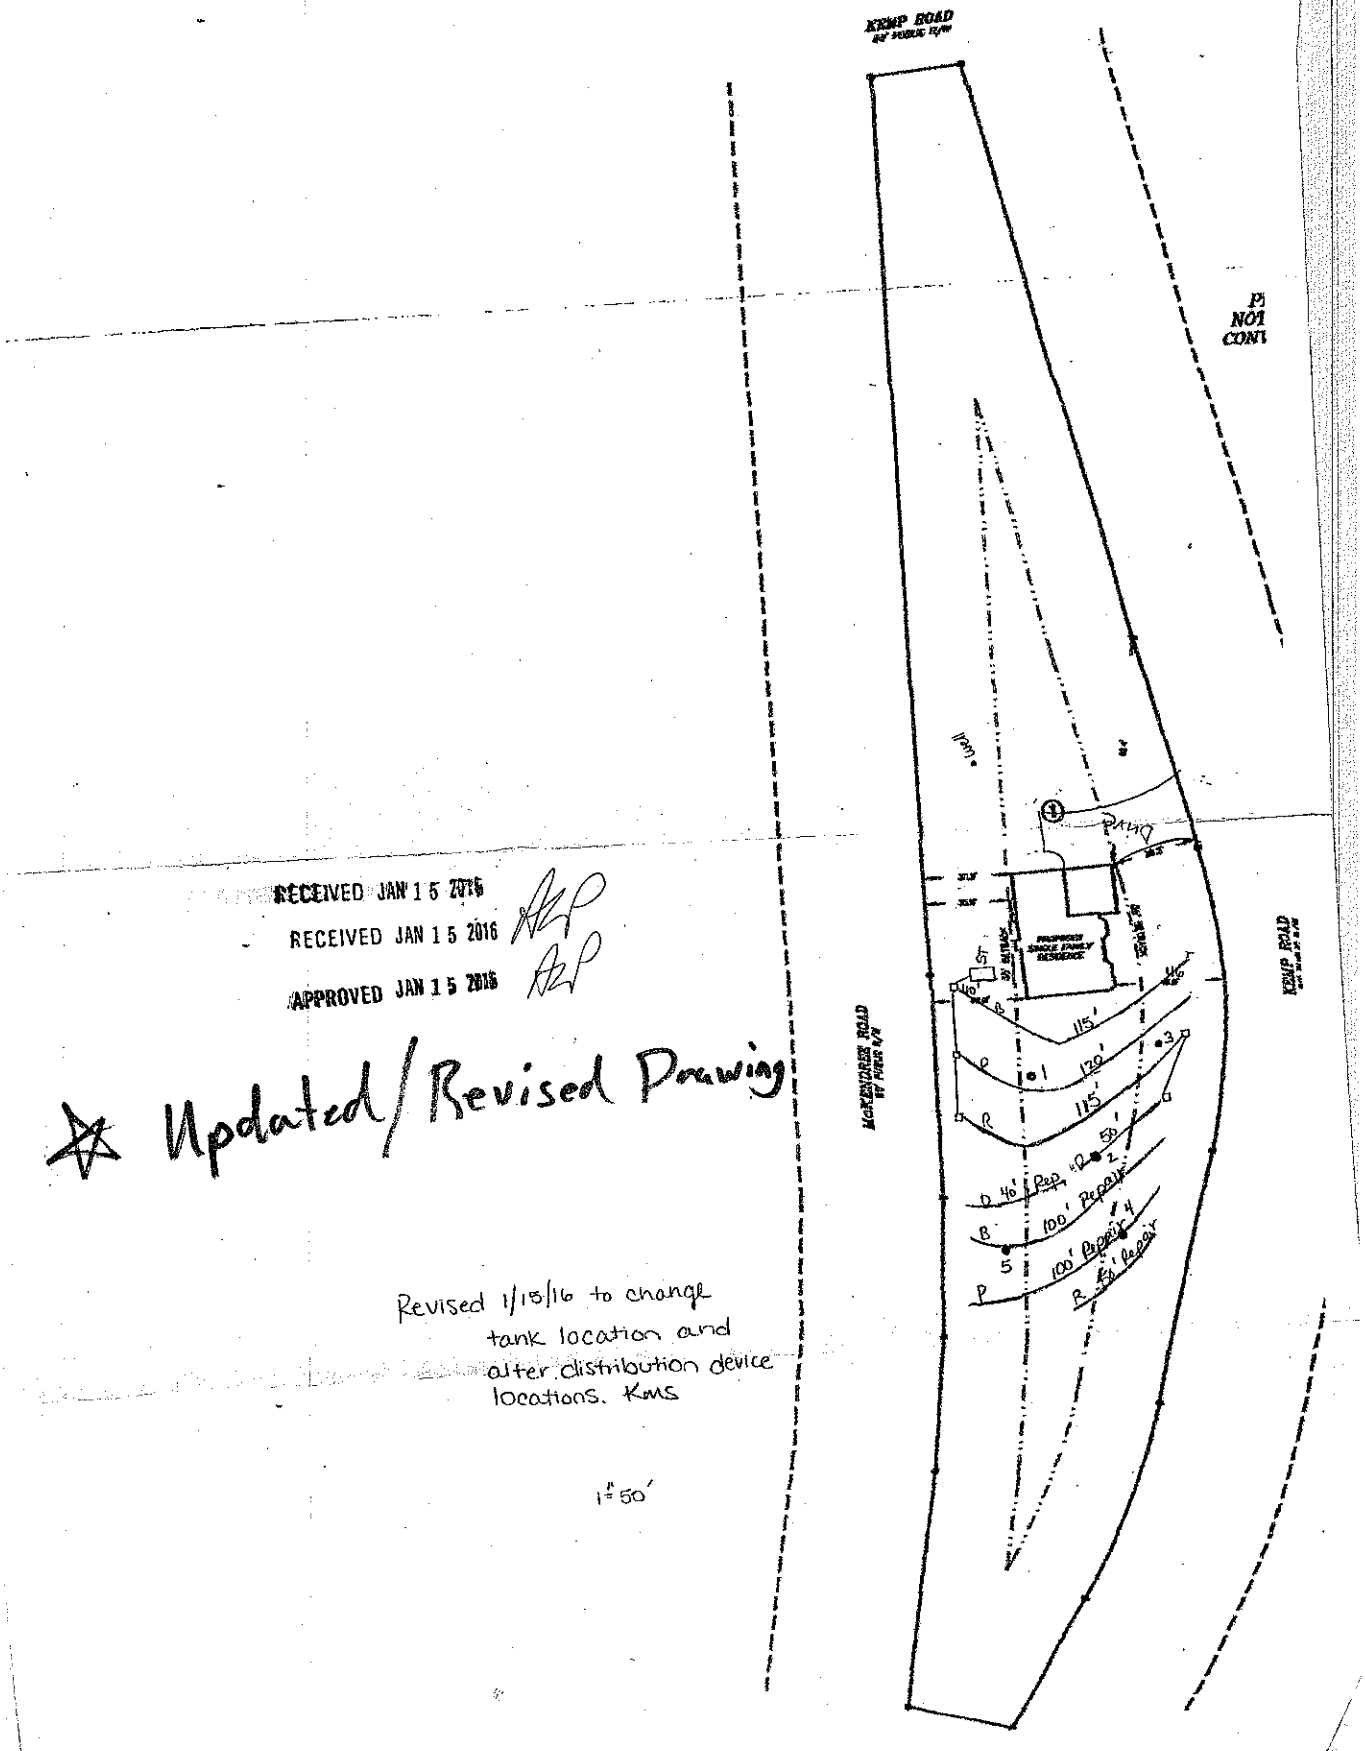

RECEIVED JAN 15 2016

RECEIVED JAN 15 2016

APPROVED JAN 15 2016

☆ Updated/Revised Drawing

Revised 1/15/16 to change tank location and alter distribution device locations. KMS

1" = 50'