IREDELL COUNTY HEALTH DEPARTMENT

Statesville Office (704) 878-5305 Mooresville Office (704) 660-3625 PERMIT # 211420

IMPROVEMENT PERMIT / AUTHORIZATION TO CONSTRUCT / OPERATION PERMIT / EXISTING SYSTEM

PIN # 4626-07-7386

APPLICANT: Russell Fox APPLICANT ADDRESS: 727 Kemp Rd.

SITE ADDRESS: Same PHONE: 704-662-7952 ALT. PHONE:

SITE DIRECTIONS: BSR, TR McKendree, TL Kemp, on L

SUBDIVISION: CLET SECTION: 8 LOT # 172 LOT AREA: .78 Ac DESIGN FLOW: L.T.A.R.:

Septic Tank (gal) STB Date
Pump Tank (gal) PT Date
Pump Make Model EXISTING Serial #
Nitrification Fields # Lines Linear Ft:
Trench Width Max. Trench Bottom Depth Gravel Depth

☐ New System ☐ Repair ☐ Expansion System Type: I II III IV V VI
System Description: EXISTING
Repair System Description:
Maintenance Agreement Required: ☐ YES ☒ NO
☒ GRAVITY ☐ PRESSURE

☐ Residence ☐ Business ☒ Other ☐ Slab ☐ Crawl Space ☒ Basement w/plumbing ☐ Basement w/o plumbing
No. Bedrooms
No. Persons
No. Employees

Water Supply: ☒ Private ☐ Public ☐ Community

Comments / Conditions:


GARAGE 25'X25'

INITIAL SITE SKETCH

GARAGE TO BE BUILT WHERE EXISTING CONCRETE IS.

1"=50'

AS BUILT SKETCH

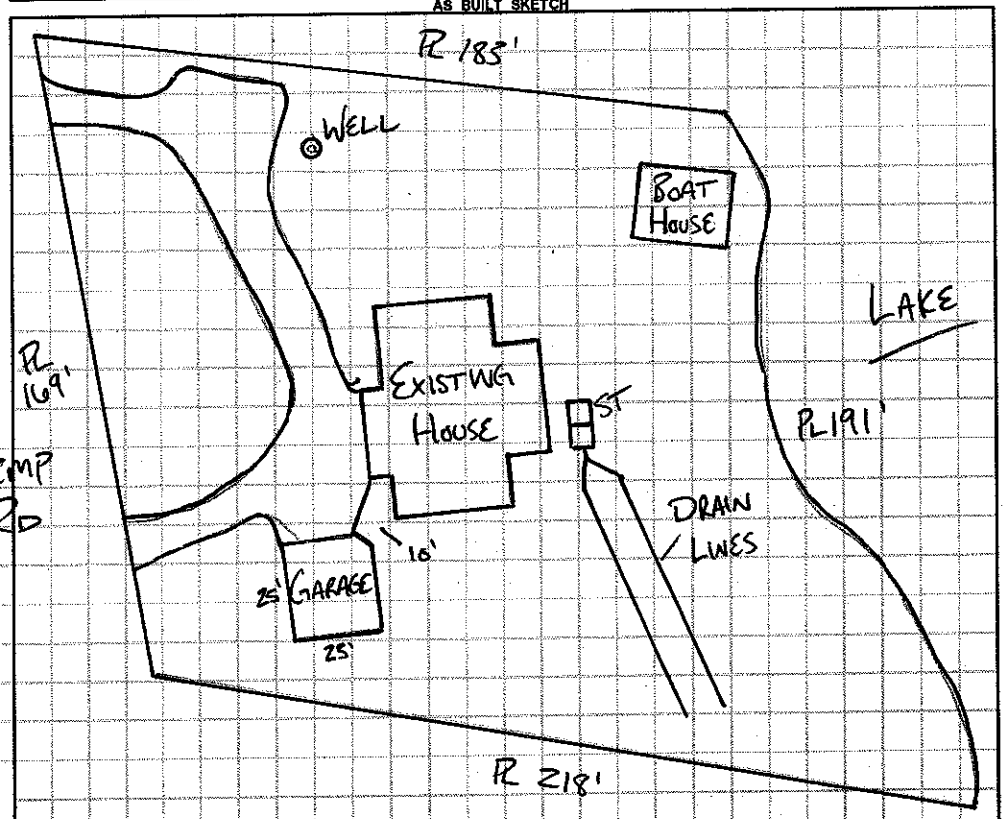

Permit can be suspended or revoked if any false information is supplied toward securing the permit / any unauthorized changes are made to the site / any unauthorized changes are made in the installation of the system. **CONTACT A LOCATOR SERVICE PRIOR TO ANY EXCAVATION**

☐ **IMPROVEMENT PERMIT** *with plat* valid without expiration ☐ **IMPROVEMENT PERMIT** *with site plan* valid for 60 mos. ☐ **AUTHORIZATION TO CONSTRUCT** valid for period equal to IMPROVEMENT PERMIT--not to exceed 60 mo.

Owner / Applicant Signature: William J Howard Date: 7-9-15

IMPROVEMENT PERMIT by: Date:

AUTHORIZATION TO CONSTRUCT by: Date:

Installed by:

OPERATION PERMIT by: Date:

Existing System Inspected by: [signature] Date: APPROVED JUN 25 2015

Health Dept. Copy - WHITE Applicant (Final Approval) - YELLOW Applicant (Conditional Approval) - PINK