IREDELL COUNTY HEALTH DEPARTMENT

STATESVILLE 704-878-5305 MOORESVILLE 704-664-5281

IMPROVEMENT PERMIT / AUTHORIZATION TO CONSTRUCT / OPERATION PERMIT / EXISTING SYSTEM INSPECTION

PERMIT # 139078 PIN # 4626-07-8014 DATE 10-15-09

OWNER or APPLICANT [redacted] SONJA COLE PHONE: Business Home:

OWNER or APPLICANT ADDRESS 108 FRESHWATER LN MOORESVILLE NC 28117

LOCATION / DIRECTIONS BSR, TR MCKENDREE, TL 2ND KEMP, TAKE RIGHT, ON L

SUBDIVISION CL+T BLOCK / SECTION 8 LOT # 174 LOT AREA .689 AC DESIGN FLOW 480 L.T.A.R. .35

Septic Tank 1000 Gallons: STB 794 Date 2-27-13
Pump Tank 1000 Gallons: PT 77 Date 3-1-13
Pump Make GOULDS Model WE05111H Serial #
Nitrification Field No Fields 1 No Lines 6 Linear Feet 240'
Trench Width 24-36" Max. Trench Bottom Depth 36" Gravel Depth SAND ☐ GRAVITY ☒ PRESSURE

☒ New System ☐ Repair ☐ Expansion System Type I II III (IV) V VI
System Description: LP- PANEL BLOCK
Repair System Description: SAME
Maintenance Agreement Required ☒ YES ☐ NO


☒ Residence No. Bedrooms 4
☐ Business No. Persons
☐ Other No. Employees
☐ Slab ☒ Crawl Space
☒ Basement w/plumbing ☐ Basement w/o plumbing

Water Supply: ☒ Private ☐ Public ☐ Community


Comments / Conditions 1) INSTALL ON CONTOUR + MEET ALL SETBACKS
2) HOUSE CAN ONLY HAVE HALF BASEMENT ON LAKE SIDE
3) EXISTING WELL MUST BE ABANDOND BEFORE OP IS ISSUED

Comments / Conditions * WILL NEED GRINDER PUMP FOR BASEMENT. MUST BE HOOKED TO PLUMBING ACCORDING TO CH7. - 712.4 OF NC PLUMBING CODE

INITIAL SITE SKETCH

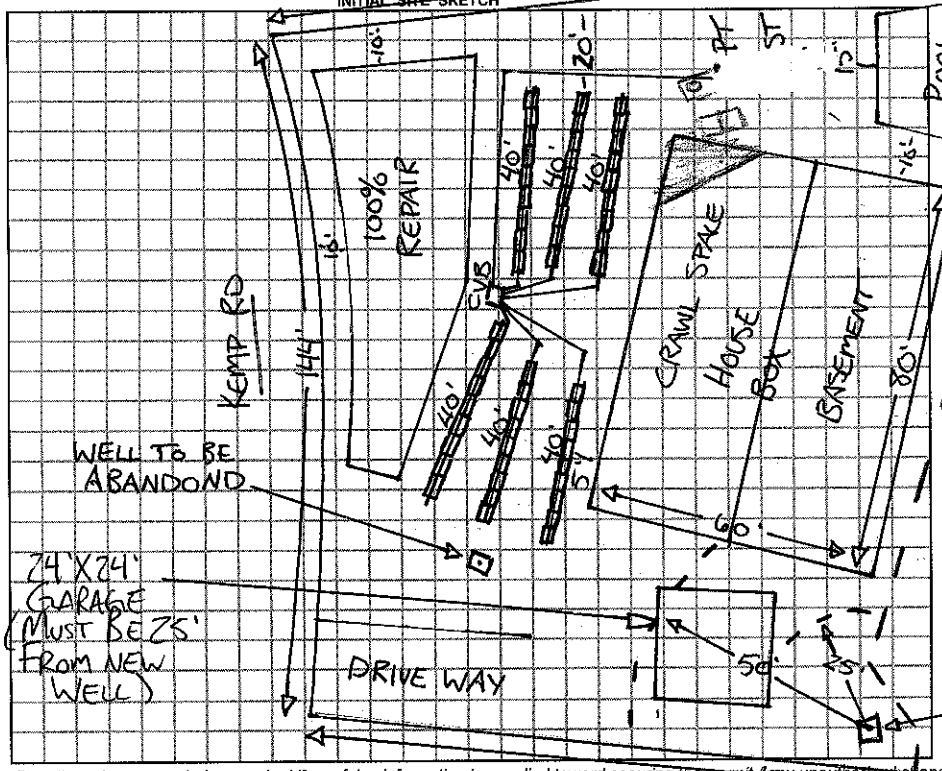

AS BUILT SKETCH

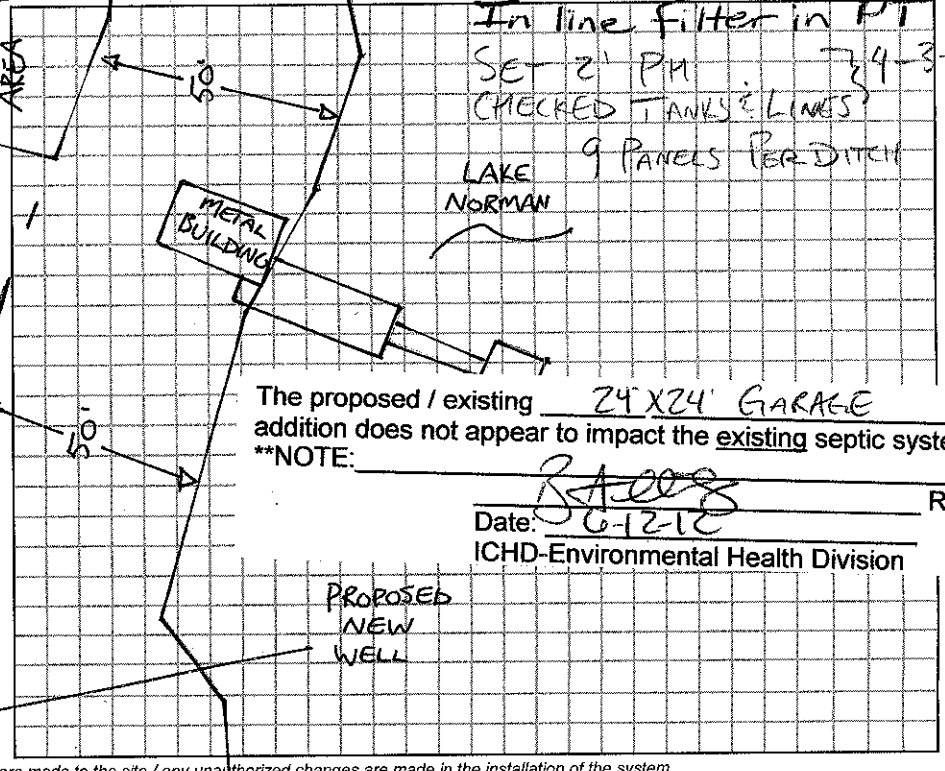

The proposed / existing 24'X24' GARAGE addition does not appear to impact the existing septic system.
**NOTE:

R.S.
Date: 6-12-12
ICHD-Environmental Health Division

Permit can be suspended or revoked if any false information is supplied toward securing the permit / any unauthorized changes are made to the site / any unauthorized changes are made in the installation of the system.

☐ IMPROVEMENT PERMIT w / plat valid without expiration. ☒ IMPROVEMENT PERMIT w / site plan valid for 60 mos. ☐ AUTHORIZATION TO CONSTRUCT valid for period equal to IMPROVEMENT PERMIT-not to exceed 60 mo.

Owner / Applicant Signature: [redacted] Date 10-16-09

Improvement Permit by: R.S. Date 10-15-09

Authorization to Construct by: REHS Date 7-3-12

YOU SHOULD CONTACT A LOCATOR SERVICE PRIOR TO ANY EXCAVATION.

Installed by: ORRISON

Operation Permit by: Date:

Existing System Inspected by: Date:

WHITE COPY Environmental Health YELLOW COPY (Final) Owner / Applicant PINK COPY (Initial) Owner / Applicant