IREDELL COUNTY HEALTH DEPARTMENT

Statesville Phone TR 3-7271 Mooresville Phone NO 3-1271

PERMIT TO INSTALL SEPTIC TANK

Permit No. 24 Permit Date MARCH 31 1971

Owner H M Beckles Address 1800 Brantley Rd. Kannapolis, NC

Installed By TEAGUE WELL DRILLING CO Address KANNAPOLIS, N C

Location of Property


SECTION 8 . LOT # 173

Tank		Capacity		Length of Lines		Fixtures	
Block	( )	1000	(✓)	225'	(✓)	No. of Baths	(✓)
Precast	(✓)	1250	( )	250'	( )	Dishwasher	( )
		1500	( )	Other		Garbage Grdr.	( )
		Other				Other	

NOTIFY HEALTH DEPARTMENT AT LEAST EIGHT HOURS BEFORE TANK IS TO BE INSPECTED.

Final Inspection March 31 1971 Approved (✓) Disapproved ( )

Remarks Well 50' from field

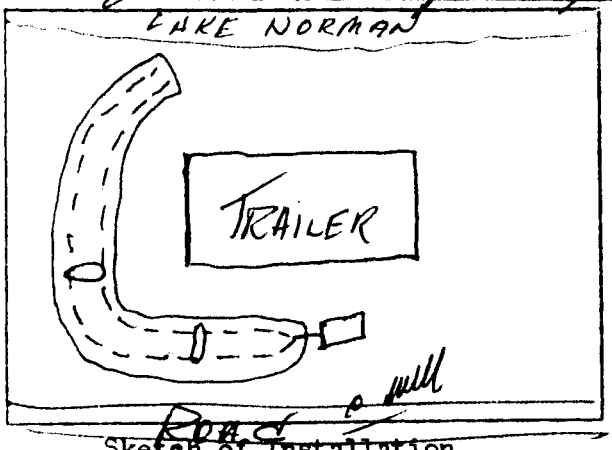

Sketch of Installation

Sanitarian